FORM 51 10M 2-49 PETROL

KANSAS


Grant

Section 21 Township 30 Range 37W

Well No. 1 Joyce

Company Hugoton Prod.

Hugoton

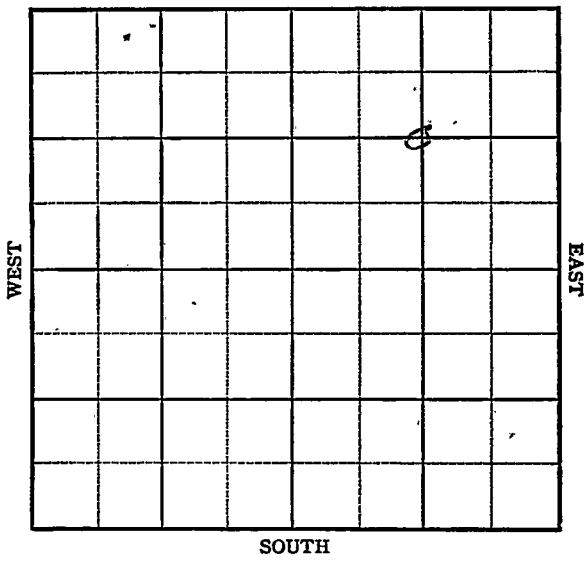

FORM 252-A
5M 10-48 PETROL

Grant KANSAS

Sec. 21 Twp. 30 R. 37W

Well No. #1 Joyce Farm

Hugoton Prod. Company

Hugoton Pool


1320' Ft. from N. Line

Ft. from S. Line

1320' Ft. from E. Line

Ft. from W. Line

C NE

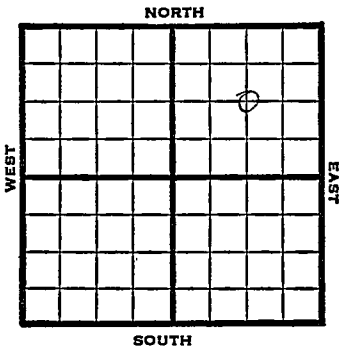

1949	Elev 3097' REPORT
9/7	Location
9/14	"
9/21	"
9/28	10"@ 583'
	Drlg 1284'
10/5	TD 2464'
	7"@ 2463'
10/12	233' of 5" Perf Liner @ 2682' TD
10/19	"
10/26	Acid 13,000
11/2	TD 2682'
	7"@ 2463'
	233' of 5" Perf Liner @ 2282'
	13000 acid
	19,490,000 Gas
	416# R Pr.
	omp
	COMPLETED

Form 26 200 Bks. 6-49 Petrol

Hugoton Pool

Kansas

Map No. Sec. 21 Twp. 30 R. 37W

Well No. 1 Joyce


Hugoton Prod. Company

Contractor

C NE

FIRST REPORT

SECTION PLAT

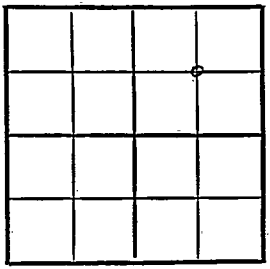

1320 Ft. from N. Line

Ft. from S. Line

1320 Ft. from E. Line

Ft. from W. Line

Grant County

Location X

Rig up

Drilling and Remarks:

RECORD

Cased in., ft.

Sand

Gas

Oil

Total Depth

PRODUCTION

1st 24 hrs. Nat.

1st 24 hrs. after shot

Gas Cu. Ft.

Dry Hole

Abandoned

Date

SEP 7 1949 19

S. J. LEWIS Scout

Form 26 200 Bks. 6-49 Petrol
Kansas

Hugoton Pool

Map No. _____ Sec. 21 Twp. 30 R. 37W.

Well No. 1 Joyce


Hugoton Prod. Company

COMPLETE Contractor

C NE

E1-2097

SECTION PLAT

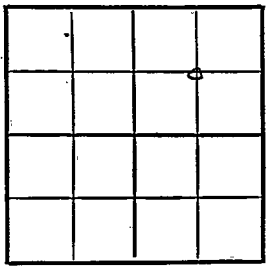

1320 Ft. from N. Line

_____ Ft. from S. Line

1320 Ft. from E. Line

_____ Ft. from W. Line

Grant County

Location _____

Rig up _____

Drilling and Remarks:

7" @ 2463

2281' of 5" Reg liner

@ 2682

3000 acid

19,490,000 Gas

4/16 # R/P

RECORD

Cased _____ in., _____ ft.

Sand _____

Gas _____

Oil _____

Total Depth 2682

PRODUCTION

1st 24 hrs. Nat. _____

1st 24 hrs. after shot _____

Gas _____ Cu. Ft.

Dry Hole _____

Abandoned _____

Date

NOV 2 1949 19

S. J. LEWIS Scout