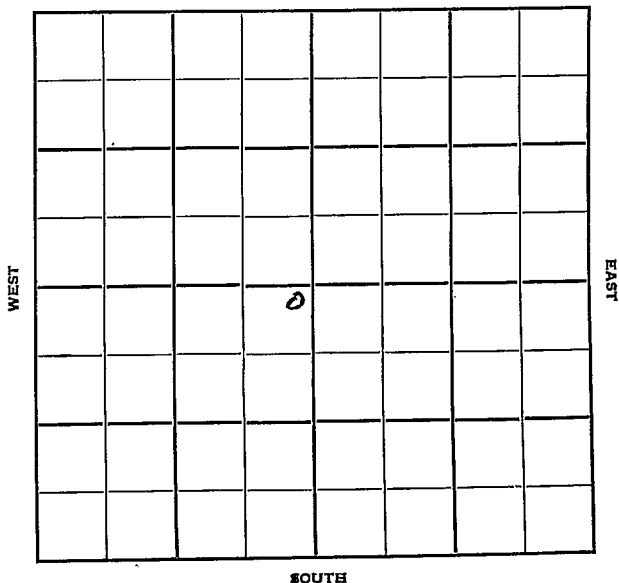


KANSAS

Grant

Section 21 Township 30 Range 38WWell No. 1 BellCompany Hugoton ProdHugoton
NORTH

KANSAS

Grant

Sec. 21 Twp. 30 R. 38W


Well No. #1 Bell Farm

Hugoton Prod.

Company

Hugoton Pool (Burris, Cont.)

NORTH

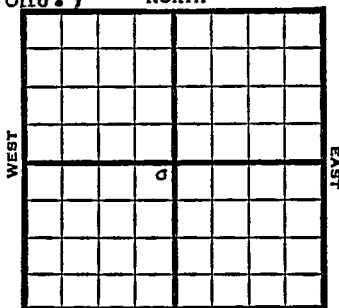

100' Ft. from N. Line

Ft. from S. Line

100' Ft. from E. Line

Ft. from W. Line

NE SW

SOUTH

1949

Elev 3159'

REPORT

6/22 Location

6/28 "

7/6 "

7/12 10" @ 605'

7/20 TD 2433

7" @ 2421'

7/27 Drlg 2563'

8/3 TD 2655'

256' of 5" Perf liner @ 2655'

3000 acid

8/10 TD 2655'

7" @ 2421'

256' of 5" Liner @ 2655'

3000 acid

3,277,000 Gas

395# R Pr.

Comp

COMPLETED

Map No. _____ Sec. 21 Twp. 30 R. 38W

Well No. 1 Bell

Hugoton Prod. _____ Company

Burriss _____ Contractor

NE SW

100 Ft. from N. Line

_____ Ft. from S. Line

100 Ft. from E. Line

_____ Ft. from W. Line

**FIRST REPORT
SECTION PLAT**

Grant County

Location X

Rig up _____

Drilling and Remarks:

RECORD

Cased _____ in., _____ ft.

Sand _____

Gas _____

Oil _____

Total Depth _____

PRODUCTION

1st 24 hrs. Nat. _____

1st 24 hrs. after shot _____

Gas _____ Cu. Ft.

Dry Hole _____

Abandoned _____

Date


JUN 22 1949 19

S. J. LEWIS Scout

Map No. 1 Sec. 21 Twp. 30 R. 38WWell No. 1 BellHugoton Prod. Company**COMPLETE**

Contractor

NE SW

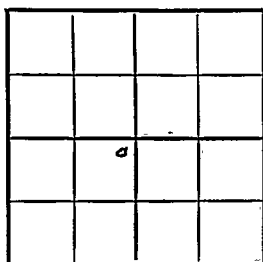E. J. 108
SECTION PLAT100 Ft. from N. Line Ft. from S. Line100 Ft. from E. Line Ft. from W. LineGrant County**RECORD**Location Rig up

Drilling and Remarks:

*5" C2421
256' 2 1/2" liner
C2655
3000000**3, 277,000 Gall**3925 R/R*Cased in., ft.Sand Gas Oil Total Depth 2655**PRODUCTION**1st 24 hrs. Nat. 1st 24 hrs. after shot Gas Cu. Ft.Dry Hole Abandoned

Date

AUG 10 1949 19S. J. LEWIS

Scout