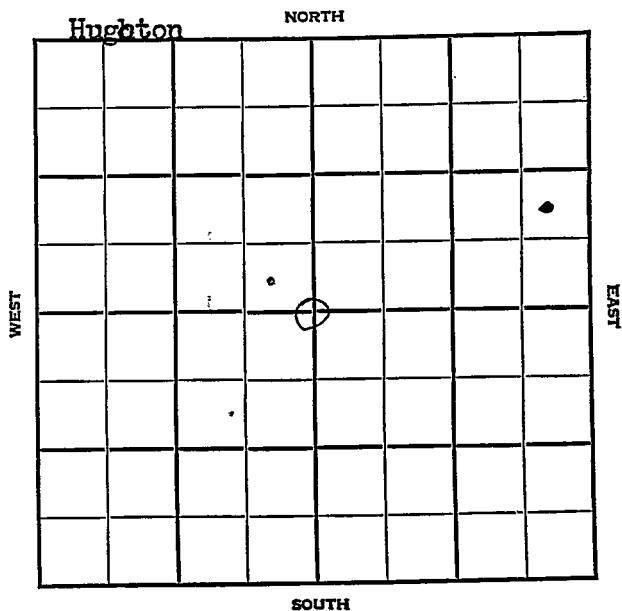


KANSAS

Stanton

Section 21 Township 30 Range 39WWell No. 1 HarkraderCompany Stanolind

Stanton ✓

Sec. 21 **KANSAS** Twp. 30 R. 39W

Well No. #1 Harkrader Farm

Stanolind

Company

Hugoton Pool


2640' Ft. from N. Line

 Ft. from S. Line

2640' Ft. from E. Line

 Ft. from W. Line

C. Sec.

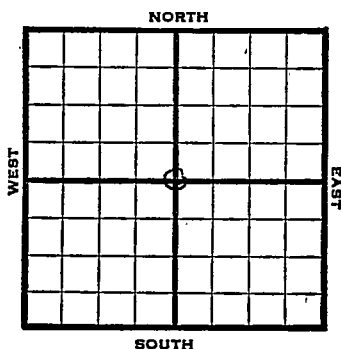

1948 Elev. 3191' REPORT

3/3 Location

3/10 10" @ 645'
Drlg. 710'

3/17 Drlg. 2350'

3/24 TD 2350'
7" @ 2344'
RUST

3/31 "

4/7 Drlg. 2405'

4/14 TD 2565'
229' of 5" Perf liner @ 2565'
17,000 Acid

4/21 "

4/28 "


5/5 7" @ 2344'
329' of 5" Perf liner @ 2565'
Acid 17,000
Gas 13,348,000
R. Pr. 440#
TD 2565'

COMPLETED

Map No. _____ Sec. 21 Twp. 30 R. 39WWell No. 1 HarkraderStanolind CompanyFIRST REPORT Contractor

C Sec.

SECTION PLAT

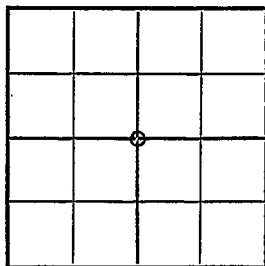2640 Ft. from N. Line Ft. from S. Line2640 Ft. from E. Line Ft. from W. Line

Stanton County

Location X

Rig up _____

Drilling and Remarks:

RECORD

Cased _____ in., _____ ft.

Sand _____

Gas _____

Oil _____

Total Depth _____

PRODUCTION

1st 24 hrs. Nat. _____

1st 24 hrs. after shot _____

Gas _____ Cu. Ft.

Dry Hole _____

Abandoned _____

Date

MAR 3 1948 19

S. J. LEWIS Scout

Map No. _____ Sec. 21 Twp. 30 R. 39WWell No. 1 Harkrader

Stanolind _____ Company

COMPLETE

Contractor


C Sec.

E 1,3191
SECTION PLAT2640 Ft. from N. Line

_____ Ft. from S. Line

2640 Ft. from E. Line

_____ Ft. from W. Line

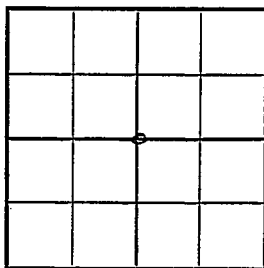

Stanton County

Location _____

Rig up _____

Drilling and Remarks:

7" @ 2344
229' of 5" Perf liner
C 2565
17000 cu ft
13,348,000 gal
440# R Br

RECORD

Cased _____ in., _____ ft.

Sand _____

Gas _____

Oil _____

Total Depth 2565

PRODUCTION

1st 24 hrs. Nat. _____

1st 24 hrs. after shot _____

Gas _____ Cu. Ft.

Dry Hole _____

Abandoned _____

Date

MAY 5 1948 19 _____ S. J. LEWIS Scout