


Stanton

KANSAS

Section 21 Township 30 Range 40N
Well No. #1 Diamond
Company Lafayette Oil Company

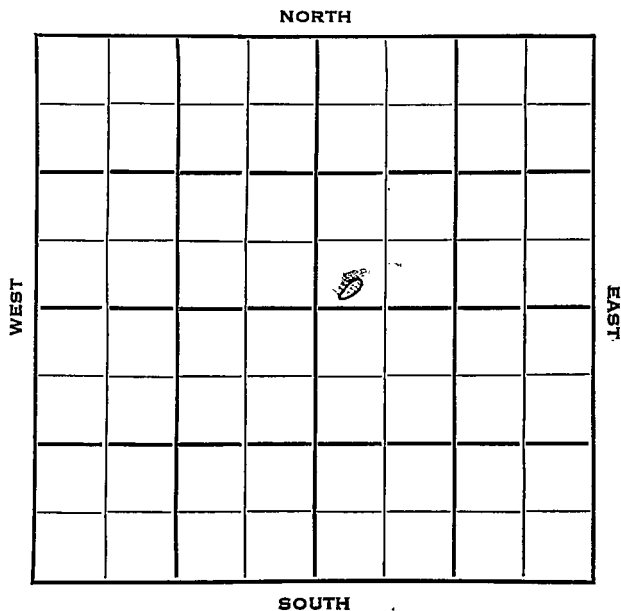

Stanton

KANSAS ✓

Sec. 21 Twp. 30 R. LOWWell No. #1 Diamond FarmLafayette Oil Company Company

Contractor


Ft. from N. Line

330 Ft. from S. Line

Ft. from E. Line

330 Ft. from W. Line

SW SW NE

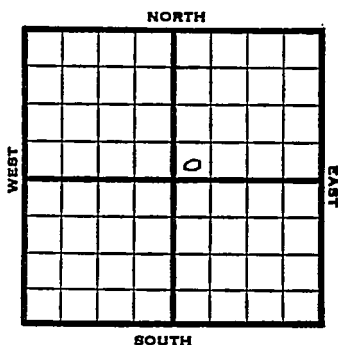

1953 Elev. 3291'

REPORT

3/4 8" @ 329 WOC

3/12 RTD 2634
5" @ 23573/19 (Cor RTD 2272, 5" @ 2256)
CO 2272'3/26 NR
4/2 "

4/8 Gas Well

TD 2272

8" @ 329

TD 2272

5" @ 2256

CO to 2272

Her 2203, Kri 2218, Win 2258

Comp. 1,458,000 gas

COMPLETED

County Stanton State Kansas

Sec. 21 (Blk. Twp.) 30 (Sur. Rge.) 40W Map No.

Operator Lafayette Oil

Well No. **1** Farm **Diamond**

Elev.	Location	SW	SW	NE
-------	----------	----	----	----

0

FIRST REPORT

330 Ft. From S Line NE

330 Ft. From ~~12~~ Line Quarter

1st. Report MAR 4 1953

Completion


Remarks

Spudding Date

Drlg. Data

8" @ 329 WOC

TGC

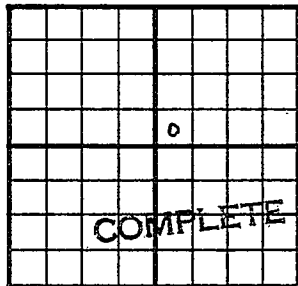County Stanton State KansasSec. 21 (Blk.
Twp.) 30 (Sur.
Rge.) 40W Map No.Operator Lafayette OilWell No. 1 Farm DiamondElev. 3291 Location SW SW NE330 Ft. From S Line NE330 Ft. From W Line QuarterIst. ReportCompletion APR 8 1953RemarksSpudding DateDrlg. Data Gas well TD 22728" @ 329 TD 2272 5" @ 2256 CO to 2272Her. 2203 Kri. 2218 Win. 2258Comp. 1,458,000 gas