


Section 22 Township 30 Range 15W

Well No. #3 Massey

Company Mid-Continent Petroleum Corp.

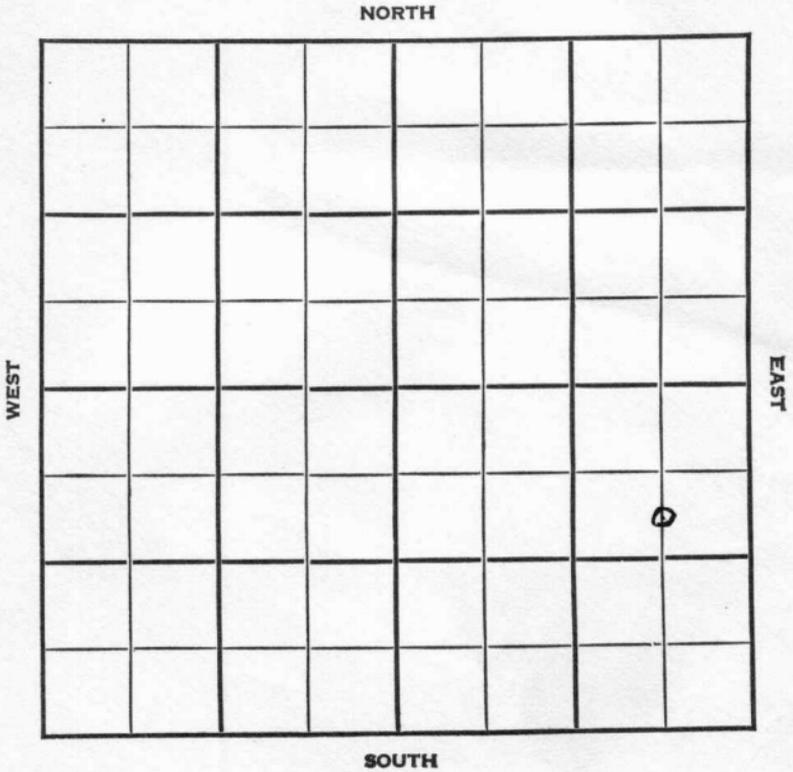

Sec. 22 Twp. 30 R. 15W

Well No. #3 Massey Farm _____

Mid-Continent Petroleum Corp. Company
Sun City


990 Ft. from N. Line

_____ Ft. from S. Line

660 Ft. from E. Line

_____ Ft. from W. Line

C S L N E S E

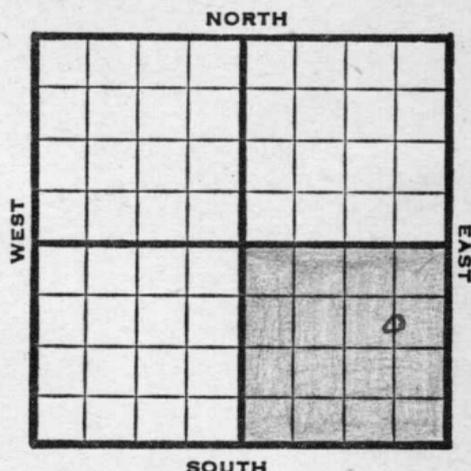

1948 Elev. 1864' **REPORT**
Massey Zone (Marmaton Lime Approx 4475')

1/21	Location	
1/29	Spud 1-28-48	
	40'	(P.R.)
1/30	Drilling 555'	"
2/2	10-3/4" set 862' WOC	"
2/3	T.D. 863' WOC	
2/4	WOC	"
2/5	Drilling 1640'	"
2/6	NR	
2/9	Drilling 2840'	"
2/11	Drlg. 3170'	
2/12	Drlg. 3300'	"
2/13	Drlg. 3515'	"
2/16	Drlg. 4015'	"
2/17	Drlg. 4105'	"
2/18	Drlg. 4200'	"
2/19	Drlg. 4288'	"
2/20	Drlg. 4373'	"
2/21	Top Massey zone 4412'	
	Slight stain to 4414'	
	Cored 4414'-4422'	
	3' recovery, no shows.	
	To take D.S.T.	(Wire)
2/24	Viola 4558'	
	T.D. 4590' Schl. water.	
	Abandoned	"

1948

2/25

Viola 4558'

TD 4590'

Abá.

~~ABANDONED~~

Map No. _____ Sec. 22 Twp. 30 R. 15W

Well No. 3 Massey

Mid-Continent Petroleum Corp. Company

FIRST REPORT

C S L NE SE Contractor


SECTION PLAT

990 Ft. from N. Line

_____ Ft. from S. Line

660 Ft. from E. Line

_____ Ft. from W. Line

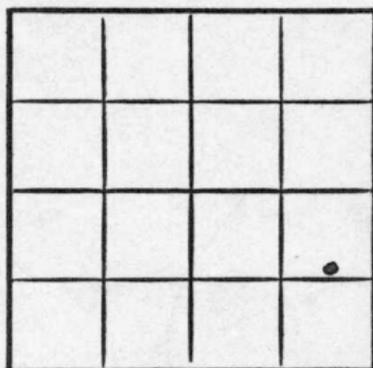

Barber County

Location X

Rig up

Drilling and Remarks:

RECORD

Cased _____ in., _____ ft.

Sand _____

Gas _____

Oil _____

Total Depth _____

PRODUCTION

1st 24 hrs. Nat. _____

1st 24 hrs. after shot _____

Gas _____ Cu. Ft.

Dry Hole _____

Abandoned _____

Date

JAN 21 1948 19

S. J. LEWIS Scout

Form No. 100 per State Land Office


Map No. _____ Sec. _____ Twp. _____ R. _____

Well No. _____

Company _____

Operator _____

SECTION PLAT

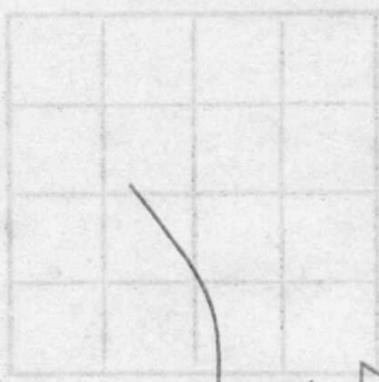

990 Ft from N. line

Ft from S. line

500 Ft from E. line

Ft from W. line

RECORD

Cased _____ in _____ ft
 Sand _____
 Gas _____
 Oil _____
 Total _____

Location _____

Rig up _____

Drilling and Remarks _____

- Misc. Small Maps _____
- Cards _____
- Tracing _____
- France Map _____
- Scarborough Map _____
- Pierce Map _____
- Geological Dept. _____
- Pierce Plat Book _____

Date _____

Map No. 92 Sec. 22 Twp. 30 R. 15W

Well No. 3 Massey

Mid-Continent Petroleum Corp. Company

ABANDONED

Contractor

C S L N E S E

E 11864
SECTION PLAT

990 Ft. from N. Line

_____ Ft. from S. Line

660 Ft. from E. Line

_____ Ft. from W. Line

			o

Barber County

Location _____

Rig up _____

Drilling and Remarks:

Vista 4538

RECORD

Cased _____ in., _____ ft.

Sand _____

Gas _____

Oil _____

Total Depth 4590

PRODUCTION

1st 24 hrs. Nat. _____

1st 24 hrs. after shot _____

Gas _____ Cu. Ft.

Dry Hole _____

Abandoned _____


Date

FEB 25 1948 19

S. J. LEWIS Scout

Form 25 - 200 Bks. - 1-18 - Palace
 Kansas
 Well No. 3-13-13
 Map No. SS Sec. 20 Twp. R. 13 N.

Contractor ABANDONED
 SECTION PLAT

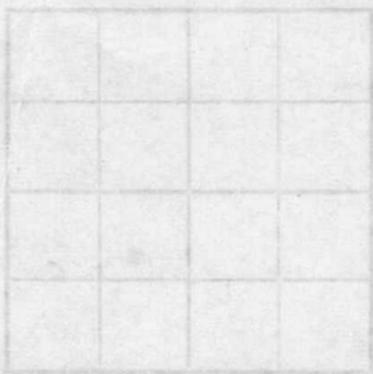

Feet from N. line
 Feet from S. line
 Feet from E. line
 Feet from W. line

RECORD
 Location
 Risk
 Drilling and Remarks
 Oil
 Gas
 Sand
 Cash
 Total Depth

- Misc. Small Maps _____
- Cards Smith
- Tracing W.H.
- France Map
- Scarborough Map
- Pierce Map _____
- Geological Dept. _____
- Pierce Plat Book _____

Date