

DRILLING WELL COMPLETION REPORT

Well No. 5 Farm Name R. H. Massey
Date completed February 24, 1948
Description SW $\frac{1}{4}$ of Sec. 22 - 30N - 10W.
County Barber, State Kansas
Initial production Dry bbls. Total depth 4590 feet
Initial volume _____ cu. ft. _____ lbs. rock pressure
Pipe Line Company _____
Gas Company _____
Remarks: _____

A. E. Pierce
ω


Mr. Koontz
Accounting Dept.
Scouting Dept. ✓
Geological Dept.
Pipe Line Dept.
Materials Dept.
Inventory Comptroller
Rental Dept.
Legal Dept.
Tax Dept.
Engineering Dept.
Lease Inventory
File

LOCATION NOTICE

TULSA, OKLA., January 22, 19 48

WELL NO. 3 ON R. N. Massey FARM

WILL BE AS FOLLOWS:

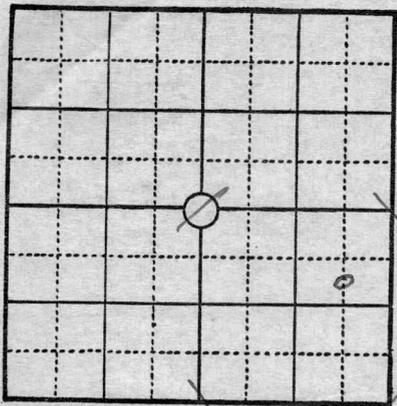

990 FEET FROM NORTH LINE
660 FEET FROM EAST LINE
 FEET FROM SOUTH LINE
 FEET FROM WEST LINE

IN SE/4 SEC. 22 TWP. 30 S RANGE 15 W
Barber COUNTY, STATE OF Kansas

REMARKS: Lloyd Snyder, Dist. Supt.

A. E. Johnson, Foreman

SIGNED A. E. Pierce

COPIES TO

- MR. KOONTZ
- DISTRICT SUPT.
- ACCOUNTING DEPT.
- SCOUTING DEPT. ✓
- GEOLOGICAL DEPT.
- PIPE LINE DEPT.
- MATERIALS DEPT.
- RENTAL DEPT.
- LEGAL DEPT.
- TAX DEPT.
- ENGINEERING DEPT.
- LEASE INVENTORY
- CLAIM DEPT.
- FILE

Leo Austin
J. W. Basore

W
Card
B. B.
Wall maps - E. E.
Small maps - E. E.