

KANSAS


FORM 51 5M 1-42 PETROL

Barber

Section 22 Township 30 Range 15-W


Well No. #1 R. N. Massey

Company Mid-Continent Pet.

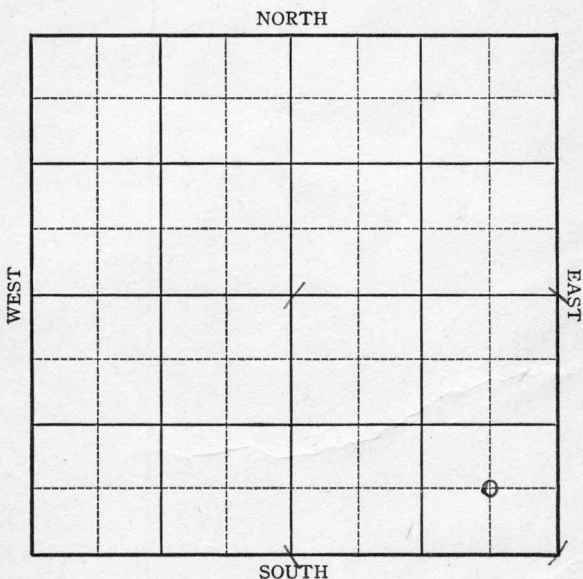

Sec. 22 Twp. 30-S R. 15-WWell No. #1 R. N. Massey FarmMid-Continent Petroleum Corp. Company

NORTH

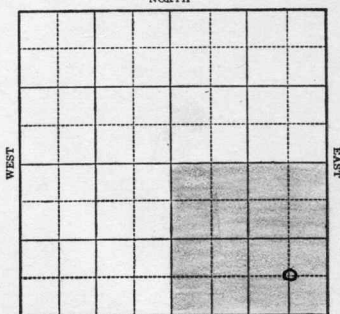

SOUTH

 Ft. from N. Line660 Ft. from S. Line660 Ft. from E. Line Ft. from W. Line

Elev. 1876' R E P O R T

1943

9/15

Location

9/22

Derrick & tools. (ticket)

9/29

Building derrick

10/4

Waiting on tools

10/6

Rigging up

10/9

" "

10/15

Drilling 1950'

10/20

Drilling 2040

10/25

Top Topeka 3190

Running 51' lower on Topeka than Pryor &
Lockhart #1 Atkins C E/2 SW 14-30S-15W (Dry)Running 10' lower on Topeka than Pryor &
Lockhart #1 Massey C SE SE 27-30S-15W (Prod.)
(Mr. Woolley)

10/26 Drilling 3753' 10/27 Andy727'

10/28 Top Lansing 3990
Drilling 4071 (Telegram)Running 3' lower on Lansing than Pryor &
Lockhart et al #1 Massey C SE NE 27-30S-15W
(Producer)Running 6' lower on Lansing than Pryor &
Lockhart et al #1 Massey C E/2 NE NW 35-30-15W
(Producer) (Mr. Beekley)11/1 Drilling 4395
Expect pay next 20 feet - if any(Tel)

OVER

1943

11/2 Drilled 2' saturation from 4420-22
Cored 4422-39 - Recovered 12 feet
Top 3' saturated porous lime
4' lime and shale partings
3' red and green shale
2' gray cherty lime
Will take another core
Total of 5 feet of saturated lime thus
far in Lower Kansas City (Mr. Moore)

11/3 Cored 4439-49 recovered 6 feet
2 feet lime
4 feet inter bedded lime and shale
No shows
Will set pipe on bottom and perforate
Had porous lime from 4282-87 where they
will perforate. They will also perforate
in the lower Kansas City where they
had saturation (Moore)

11/4 T.D. 4449' Setting 5" casing 4447'

11/5 Waiting on cement

11/6 " " "

11/9 Rigging up tools to drill plugs
Now waiting on tanks before drilling
cement

11/10 Bailing

11/11 Drilled cement.

Perforated 35 shots 4419-25

Filled up with 2200 feet oil in 1 hour
and 25 minutes

Filled up and started to flow in $3\frac{1}{2}$ hrs

Shut in - Tankage not completed yet.

This was perforated in the lower

Kansas City or Marmaton. (Tel)

11/11 Flowing 14 barrels per hour natural
Will acidize (Wire Lewis)

11/16 T.D. 4449; PB 4428

Acidized with 2000 gallons

Well flowed 76 bbls per hour thru
tubing

11/17 Waiting on State man to take
Potential

11/18 Will take potential

OVER

1943

11/22 T.D. 4449

Plugged back 4428

Acidized with 2000 gallons

Well flowed 76 bbls per hour thru tubing.

Completed for a bomb potential of 4864 barrels per day (Telegram)

11/24 5" @ 4449'

Lans 3990

35 shots 4419-25

2000 acid

Bomb.Potential 4864'

Max. 3000

TD 4449'

Gravity 31°

COMPLETED

Sec. _____ Twp. _____ R. _____

Well No. _____ Farm _____


_____ Company _____

_____ Ft. from N. Line

_____ Ft. from S. Line

_____ Ft. from E. Line

_____ Ft. from W. Line

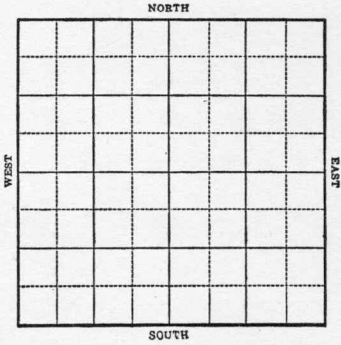


R E P O R T

KANSAS

Map No. 92 Sec. 22 Twp. 30 R. 15WWell No. 1 R. N. MasseyMid-Continent Pet. CompanyFIRST REPORT Contractor

C SE SE

SECTION PLAT

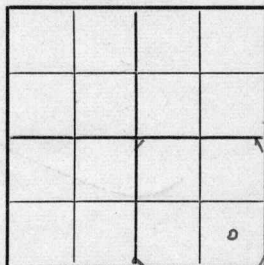 Ft. from N. Line660 Ft. from S. Line660 Ft. from E. Line Ft. from W. LineSun City PoolLocation Rig up

Drilling and Remarks:

Derrick & tools

Special

RECORD

Cased in., ft.Sand Gas Oil Total Depth

PRODUCTION

1st 24 hrs. Nat. 1st 24 hrs. after shot Gas Cu. Ft.Dry Hole Abandoned


Date

SEP 22 1943 19S. J. LEWIS Scout

Form No. 1
 Map No. _____
 Sec. _____
 Twp. _____
 R. _____
 Well No. _____

Company _____
 Contractor _____

SECTION PLAT

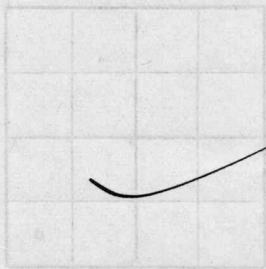

ft. from N. Line
 ft. from S. Line
 ft. from E. Line
 ft. from W. Line

RECORD

Location _____
 This up _____
 Drilling and Remarks: _____
 Gas _____
 Oil _____
 Total Depth _____

Misc. Small	_____
Cards	_____
Tracing	_____
France Map	_____
Scarborough	_____
Moody Map	_____
Geological Dept.	_____
Moody Lat Book	_____

And
Good
MEP
[Signature]


Date _____

KANSAS

Map No. 92 Sec. 22 Twp. 30 R. 15WWell No. 1 R. N. MesseyMid-Continent Pet. CompanyCOMPLETED Contractor

C SE SE

SECTION PLAT

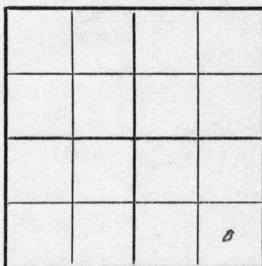 Ft. from N. Line660 Ft. from S. Line660 Ft. from E. Line Ft. from W. Line

Sun City Pool

Location Rig up

Drilling and Remarks:

Land 39905-10 444935x hole 4419-252000 acidBorn & P 4864Max 3000

RECORD

Cased in., ft.Sand Gas Oil Total Depth 4449

PRODUCTION

1st 24 hrs. Nat. 1st 24 hrs. after shot Gas Cu. Ft.Dry Hole Abandoned

Date

3/2/42

NOV 24 1943 19

S. J. LEWIS Scout




Contractor

SECTION PLAT



From N. Line

660 From S. Line

660 From E. Line

660 From W. Line







[Signature]

Scarborough Map
Pierce Map
Geological Dept.
Pierce Plat Book

Date