


Section 22 Township 30 Range 13W

Well No. #1 O'Dell

Company Lion Oil Ref.

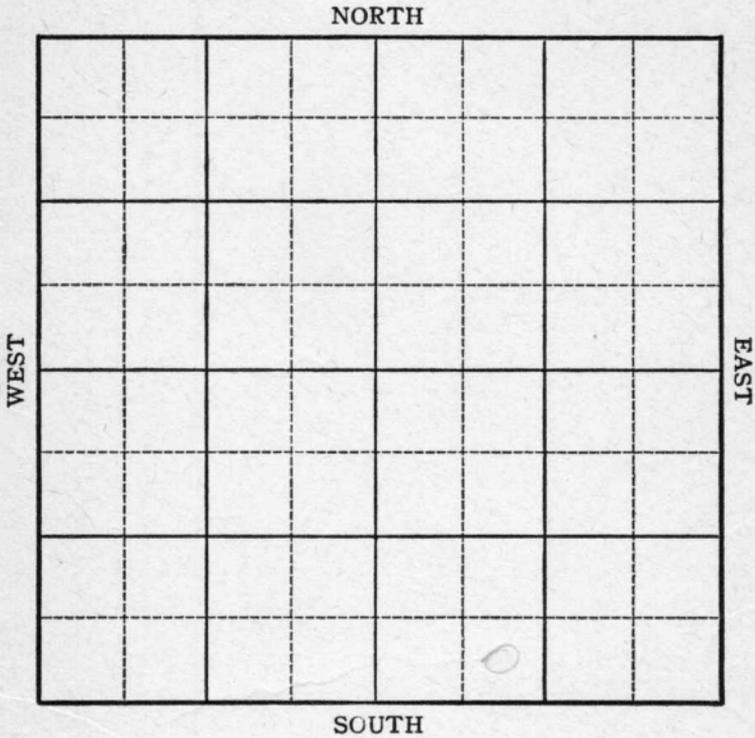

KANSAS

Barber County

Sec. 22

Twp.

30 *Special* R. 13W

Well No. #1 O'Dell

Farm

Lion Oil Ref.

Company

Marjorie


\_\_\_\_\_ Ft. from N. Line

330 Ft. from S. Line

\_\_\_\_\_ Ft. from E. Line

990 Ft. from W. Line

SE SW SE *Elev. 1850*

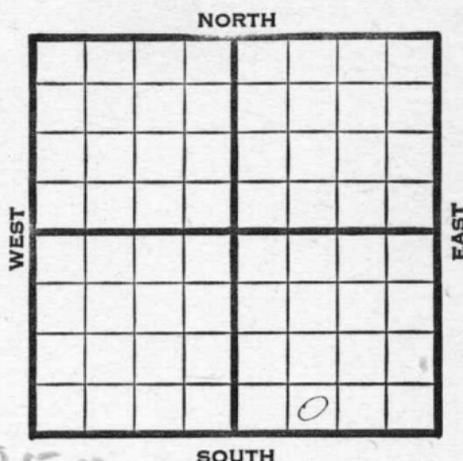

1945

REPORT

3/28

RUR

4-4

Set 8" @ 580'  
Drilling 2450'

4-12

Lansing 3111'  
Drilling 4340'

4-18

Simpson 4664'  
Sand 4679'  
Drilling 3910'

5/9

Simp Sd 4679  
5" @ 4686  
TD 4692  
11000 acid.

ABANDONED



Kansas Pool Name Marjorie

Map No. 92 Sec. 22 Twp. 30 R. 13W

Well No. 1 O'Dell

Lion Oil Ref. \_\_\_\_\_ Company \_\_\_\_\_

ABANDONED

Contractor \_\_\_\_\_

SE SW SE

*E. 1850*  
SECTION PLAT


\_\_\_\_\_ Ft. from N. Line

330

\_\_\_\_\_ Ft. from S. Line

\_\_\_\_\_ Ft. from E. Line

990

\_\_\_\_\_ Ft. from W. Line

Barber County

Location \_\_\_\_\_

Rig up \_\_\_\_\_

Drilling and Remarks:

*Sum. Del 4679  
5" @ 4686  
11000 acid.*

**RECORD**

Cased \_\_\_\_\_ in., \_\_\_\_\_ ft.

Sand \_\_\_\_\_

Gas \_\_\_\_\_

Oil \_\_\_\_\_

Total Depth 4692

**PRODUCTION**

1st 24 hrs. Nat. \_\_\_\_\_

1st 24 hrs. after shot \_\_\_\_\_

Gas \_\_\_\_\_ Cu. Ft.

Dry Hole \_\_\_\_\_

Abandoned \_\_\_\_\_

Date

MAY 9 1945 19 \_\_\_\_\_

S. J. LEWIS

Scout