


KANSAS Barber

FORM 51 5M PETROL

Section 22 Township 30 Range 14W

Well No. 1 Werner

Company Huber

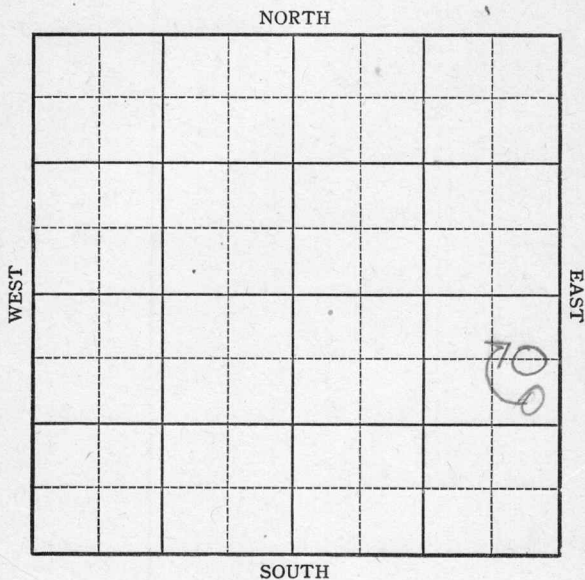

KANSAS

B arber

Sec. 22 Twp. 30 R. 14W

Well No. 1 Werner Farm

Huber Company


Wildcat

~~990~~ 660 Ft. from N. Line

 Ft. from S. Line

330 Ft. from E. Line

 Ft. from W. Line

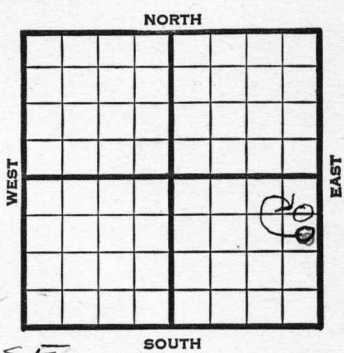

~~SE NE SE~~ CEL NE SE

1945 Elev. 1903 REPORT

4/25	derrick
5/3	"
5/10	Drlg. 600'
5/17	10" @ 802
	978 lost circulation
	8" @ 1024
	Drlg. 1150
5/24	Drlg. 3130
6/6	Miss. 4482
	Simp Sd. 4708
	Arb. 4788
	TD 4795'

ABANDONED


Kansas Pool Name WildcatMap No. 92 Sec. 22 Twp. 30 R. 14WWell No. 1 WernerHuber Company

FIRST REPORT

Contractor

SE NE SE

SECTION PLAT

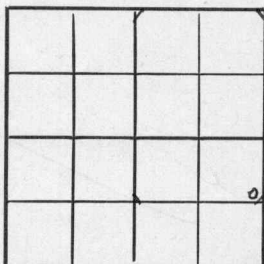990 Ft. from N. Line Ft. from S. Line330 Ft. from E. Line Ft. from W. LineBarberLocation Rig up Drilling and Remarks:
derrick

RECORD

Cased in., ft.Sand Gas Oil Total Depth

PRODUCTION

1st 24 hrs. Nat. 1st 24 hrs. after shot Gas Cu. Ft.Dry Hole Abandoned Date

APR 25 1945

19

S. J. LEWIS

Scout

Misc. Small

Cards

Tracing

Trance Map

Scarborough Map

Moody Map

Geological Dept.

Moody Plat Book

Kansas Pool Name WildcatMap No. 92 Sec. 22 Twp. 30 R. 14WWell No. 1 WernerHuber Oil

Company

CORRECTION

Contractor

C E L N E S E

SECTION PLAT

			o

660 Ft. from N. Line

Ft. from S. Line

330 Ft. from E. Line

Ft. from W. Line

Barber

Location

Rig up

Drilling and Remarks:

reported

SE NE SE

RECORD

Cased _____ in., _____ ft.

Sand _____

Gas _____

Oil _____

Total Depth _____

PRODUCTION

1st 24 hrs. Nat. _____

1st 24 hrs. after shot _____

Gas _____ Cu. Ft.

Dry Hole _____

Abandoned _____

Date

MAY 23 1945

19

S. J. LEWIS

Scout

Misc. Small Maps

Cards

Tracing

France Map

Scarborough Map

Pierce Map

Geological Dept.

Pierce Map

Kansas Pool Name WildcatMap No. 92 Sec. 22 Twp. 30 R. 14 WWell No. 1 WernerHuber Oil


Company

ABANDONED

Contractor

C E L N E S E

SECTION PLAT

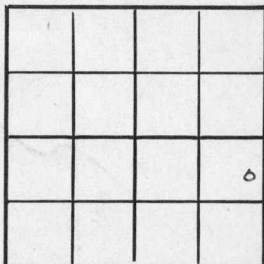660 Ft. from N. Line Ft. from S. Line330 Ft. from E. Line Ft. from W. LineBarber CountyLocation Rig up

Drilling and Remarks:

Miss 4482
Sing Sol 4708
Cr X 4788

RECORD

Cased in., ft.Sand Gas Oil Total Depth 4795


PRODUCTION

1st 24 hrs. Nat. 1st 24 hrs. after shot Gas Cu. Ft.Dry Hole Abandoned

Date

JUN 6 1945 19S. J. LEWIS

Scout

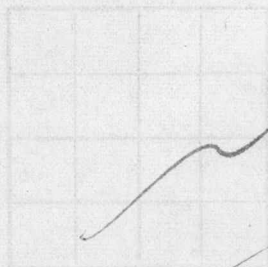

Place Names	_____
Cards	_____
Tracing	_____
France Map	_____
Scarborough Map	_____
Pierce Map	_____
Geological Dept.	_____
Pierce Plat Book	_____