
FORM 51 10M 7-48 PETROL

KANSAS Grant

Section 22 Township 30 Range 36W

Well No. 1 Owens

Company United Prod.

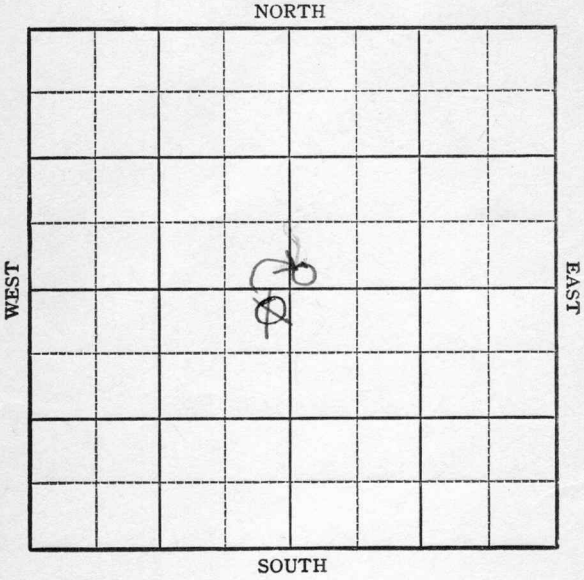

FORM 252-A
5M 4-48 PETROL

KANSAS

Grant

Sec. 22 Twp. 30 R. 36W

Well No. #1 Owens Farm

United Prod. Company

Hugoton Pool


~~100'~~ Ft. from N. Line

100' Ft. from S. Line

~~100'~~ Ft. from E. Line

100' Ft. from W. Line

~~NE SW~~ SW NE

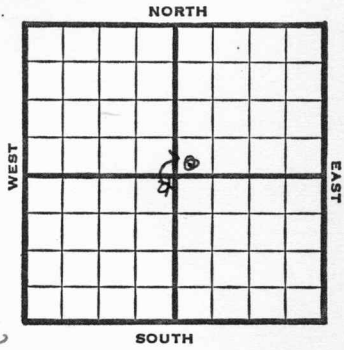

1948	Eli 2929' REPORT
7/28	RUR
8/4	"
8/11	10"@ 447' Drlg 1846'
8/18	TD 2423' 7"@ 2421'
8/25	TD 2626' 215' of 5" Perf Liner @ 2626'
9/1	"
9/8	Acid 14,000
9/14	"
9/21	"
9/29	TD 2626' 7"@ 2421' 215' of 5" perf liner @ 2626' 14000 acid 9,680,000 gas 390# R Pr. Comp COMPLETED

Form 27—100 Bks.—4-48—Petrol

Grant County Kansas State

Map No. Sec. 22 Twp. 30 R. 36W


Well No. 1 Owens

United Prod. Company

FIRST REPORT Contractor

NE SW

SECTION PLAT

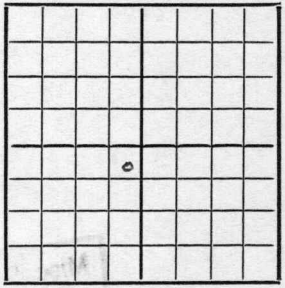

100 Ft. from N. Line

Ft. from S. Line

100 Ft. from E. Line

Ft. from W. Line

Hugoton Pool

Remarks:

R U R

Date JUL 28 1948 Scout S. J. LEWIS

Form 27—100 Bks.—4-48—Petrol

Grant County Kansas State

Map No. Sec. 22 Twp. 30 R. 36W


Well No. 1 Owens

United Prod. Company

CORRECTION Contractor

SW NE

SECTION PLAT

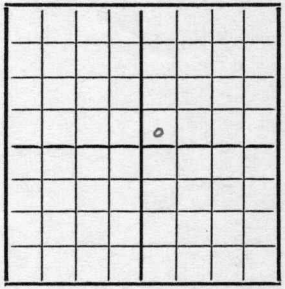

Ft. from N. Line

100 Ft. from S. Line

Ft. from E. Line

100 Ft. from W. Line

Hugoton Pool

Remarks:

Reported NE SW

Date AUG 18 1948 Scout S. J. LEWIS

Form 26—200 Bks.—1-48—Palace

Kansas

Hugoton Pool

Map No. _____ Sec. 22 Twp. 30 R. 36W

Well No. 1 Owens


United Prod. Company

COMPLETE Contractor

SW NE

E 1/2 SE

SECTION PLAT

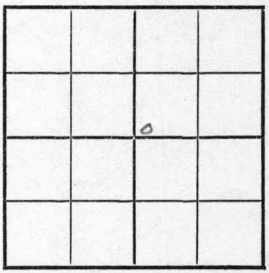

_____ Ft. from N. Line

100 Ft. from S. Line

_____ Ft. from E. Line

100 Ft. from W. Line

Grant County

Location _____

Rig up _____

Drilling and Remarks:

7" @ 2421

215' of 5" Perf liner

@ 2626

1400 acid

9,650,000 Gas

890 # R/P

RECORD

Cased _____ in., _____ ft.

Sand _____

Gas _____

Oil _____

Total Depth 2626

PRODUCTION

1st 24 hrs. Nat. _____

1st 24 hrs. after shot _____

Gas _____ Cu. Ft.

Dry Hole _____

Abandoned _____

Date

SEP 29 1948 19____ S. J. LEWIS Scout