Haskell


FORM 51 IOM 12-46 PETROL

KANSAS

Section 22 Township 30 Range 34W

Well No. 1 Willet

Company Trees Oil

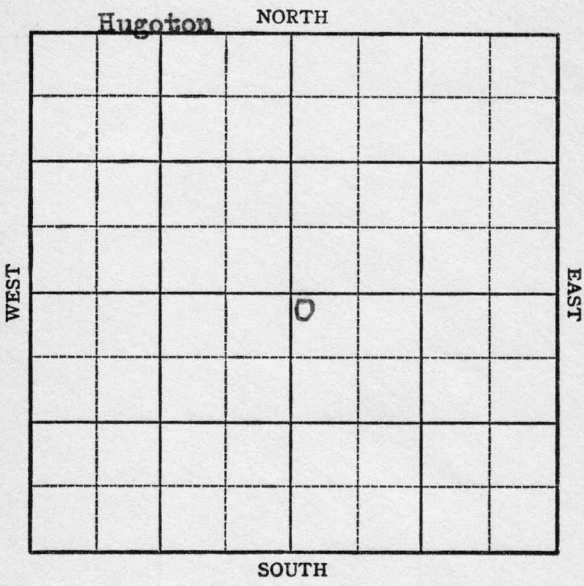

FORM 252-A
5M 9-47 PETROL

KANSAS Haskell

Sec. 22 Twp. 30 R. 34W

Well No. #1 Willet Farm

Trees Oil Company

Hugoton


100 Ft. from N. Line

Ft. from S. Line

Ft. from E. Line

100 Ft. from W. Line

NW SE

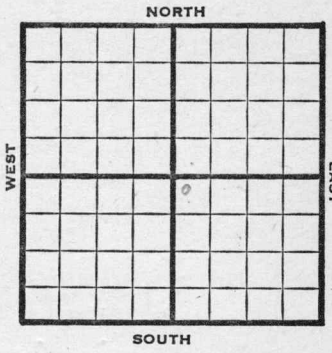

1947	Elev. 2948' REPORT
9/10	10" @ 601 drlg. 2175
9/17	TD 2500' 7" @ 2492'
9/24	"
10/1	"
10/8	"
10/15	"
10/22	"
10/29	"
11/5	TD 2727'
11/12	240' of 5" Perf. Liner @ 2727' 1000 acid.
11/19	"
11/25	"
12/3	"
12/10	"
12/17	"
12/30	"
1948 1/7	"

OVER

1948

1/14 240' of 5" Perf liner @ 2727'
1000 acid

1/21 "

1/26 Total 16000 acid

2/4 "

2/11 7" @ 2492'
240' of 5" perf. liner @ 2727'
16,000 acid
29,946,000 Gas.
419# R. Pr.
TD 2727'
Comp.

COMPLETED

Form 26 200 Bks. 10-46 Petrol

Hugoton Pool

Kansas

Map No. _____ Sec. 22 Twp. 30 R. 34W

Well No. 1 Willet

Trees Oil Company

FIRST REPORT

Contractor

NW SE


100 Ft. from N. Line

_____ Ft. from S. Line

_____ Ft. from E. Line

100 Ft. from W. Line

SECTION PLAT

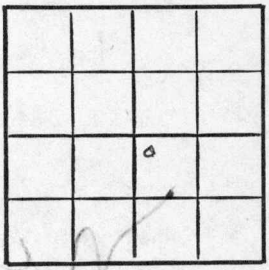

Haskell County

Location

Rig up

Drilling and Remarks:

10" @ 601

drlg. 2175

RECORD

Cased _____ in., _____ ft.

Sand

Gas

Oil

Total Depth

PRODUCTION

1st 24 hrs. Nat.

1st 24 hrs. after shot

Gas _____ Cu. Ft.

Dry Hole

Abandoned

Date

SEP 10 1947 19

S. J. LEWIS Scout



Misc. Small Maps
Cards EN
Tracing
France Map
Scarborough Map
Pierce Map
Geological Dept.
Pierce Flat Desk

Form 26 200 Bks. 10-46 Petrol

Kansas

Hugoton Pool

No Map

Map No. _____ Sec. 22 Twp. 30 R. 34W

Well No. 1 Willet


Trees Oil Company

COMPLETE Contractor

NW SE

E 1,2945

SECTION PLAT

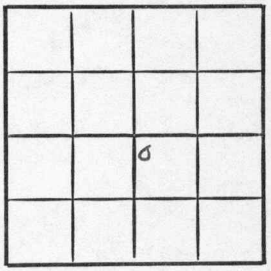

100 Ft. from N. Line

_____ Ft. from S. Line

_____ Ft. from E. Line

100 Ft. from W. Line

Haskell County

Location _____

Rig up _____

Drilling and Remarks:

7" @ 2492

240' of 6" Perf liner @ 2727.

16000 acid

29,946,000 Gas

419 # R/P

RECORD

Cased _____ in., _____ ft.

Sand _____

Gas _____

Oil _____

Total Depth 2727

PRODUCTION

1st 24 hrs. Nat. _____

1st 24 hrs. after shot _____

Gas _____ Cu. Ft.

Dry Hole _____

Abandoned _____

Date

FEB 11 1948 19 S. J. LEWIS Scout

Misc. Small Maps
Cards
Tracing
France Map
Scarborough Map
Pierce Map
Geological Dept.
Pierce Plat Book