


Section 22 Township 30 Range 8W

Well No. 2 Frank Rall

Company Magnolia Petr.

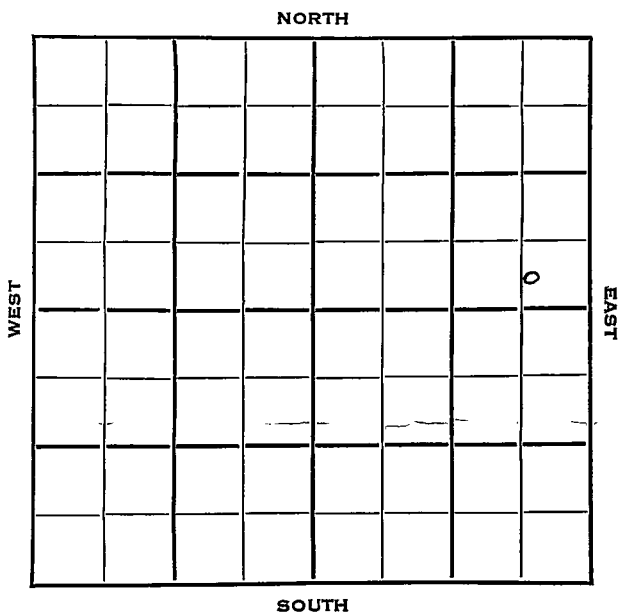

1954
4/14

Spud 3-5-54

Oil Well

TD 4332'

9" @ 200'

KC 3414', Miss 4176'

DST 4176-95', opn 1 hr., rec. 40' gas,
20' sgcm, 60#

DST 4196-4230', opn 1 hr., rec. 50'
gcm, 1020#

DST 4243-68', opn 1 hr., rec. 280'
sg & mco, 50' oil, 10' wtr, 1585#

TD 4332'

5" @ 4331'

CO to 4298'

8/4266-68, 56/4244-58, frac.

F/51 bo 5 bw 4 hrs.

F/90 bo 6 bw 6 hrs.

F/82 bo 6 bw 6 hrs.


Comp. 294 bopd

COMPLETED

Scout Cards	<i>MM</i>
Land Small Map	
Land Wall Map	<i>33</i>
Tracings	
France Map	
Picnic Map	
Misc.	

MAR 4 1954

Orig. Data

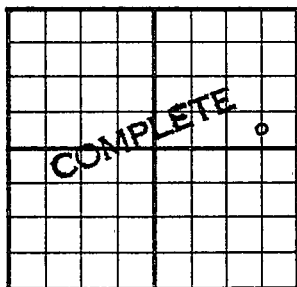County Kingman State KansasSec. 22 (Blk. Twp.) 30 (Sur. Rge.) 8W Map No.Operator Magnolia Pet.Well No. 2 Farm Frank RallElev. 1530 Location C S L SE-NE330 Ft. From S Line NE530 Ft. From E Line Quarter

1st. Report _____

Completion APR 14 1954

Remarks _____

Prime Drlg. - Contr.Spudding Date 3-5-54Drlg. Data Oil well TD 43329" @ 200 KC 3414 Miss. 4176DST 4176-95 open 1 hr. Rec. 40' gas20' sgcm 60# DST 4196-4230 open 1 hr.Rec. 50' gcm 1020# DST 4243-68 open1 hr. Rec. 280' sg & mco 50' oil10' wtr. 1585# TD 4332 5" @ 4331CO to 4298 8/ 4266-68 56/ 4244-58frac F/ 51 bo 5 bw 4 hr. F/ 90 bo6 bw 6 hr. F/ 82 bo 6 bw 6 hr.Comp. 294 bopd

APR 20 1954

Scout Cards	10
Land Small Map	
Land Wall Map	3
Tracings	
France Map	
Pierce Map	
Misc.	