


Kingman

KANSAS

DX 78-1

Section 22 Township 30 Range 8W
Well No. #1 Tjaden "D"
Company Pickrell Drlg.

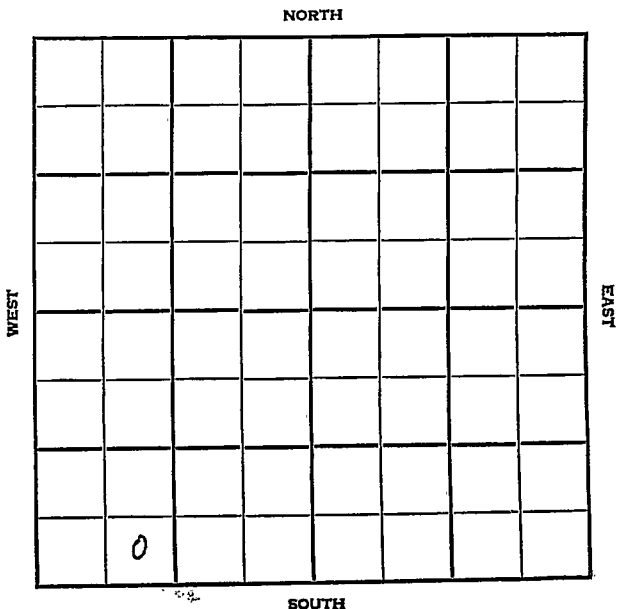

KANSAS

SEC.	TWP.	R.
22	30	8W
WELL NO.		
#1 Tjaden "D"		
FARM		
COMPANY		
Pickrell Drlg.		
CONTRACTOR		


Spivey Pool

_____ Ft. from N. Line

330 _____ Ft. from S. Line

_____ Ft. from E. Line

990 _____ Ft. from W. Line

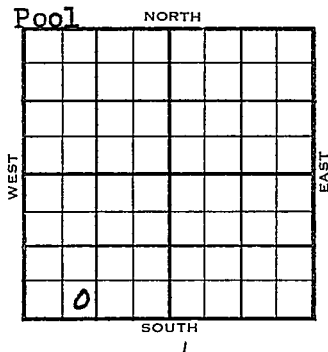

SE SW SW
SinclairF/O

ELEVATION		REPORT
1955	1598	
4/13	Spud 4-12-55 Drlg. 100'	
6/29	Comm 4-12-55 L 3506 M 4280 DST 4310-48 open 1 hr, gas to surface 1 hr Rec 120' gcm 180/30" 5½" @ 4406/125 CO to 4370 24/4315-21 40/4323-33 S/1 boph 4 hr 500 M-A F/5 boph 3 hr Comp F/103 bopd 18% wtr.	

COMPLETED

FABEN GILSTRAP

County Kingman Elev. 1598
Sec. 22 Twp. 30 Rgs. 8W
Company Pickrell Drlg.
FarmName Tjaden "D" No. 1

TOPS	DEPTH	LOG	DATUM	Loc. in Sec.
Anh.				SE SW SW
Tp.				
H.				
Tr.				
Dg.				
Bl.				
L.	3506		1908	Geol.
K.C.				Contr.
B.K.C.				
Ce.				
C.				
M.	4280		2682	Pool
M.				Spivey
K.				
Mz.				
Me.				
V.				
S.				
S.				
A.				
R.				
Pf.				
G.				
TD.	4407			

Date Comm. 4-12-55 JUN 29 1955
DST 4310-48 open 1 hr. gas to surface
1 hr. Rec. 120' gcm 180/30" 5 1/2" @
4406/125 CO to 4370 24/ 4315-21
40/ 4323-33 S/ 1 boph 4 hr. 500 M-A
F/ 5 boph 3 hr. Comp. F/ 103 bopd
18% wtr.