


Kingman KANSAS

DX 78-1

Section 22 Township 30 Range 8W

Well No. 1 C. J. Boyle "H"

Company Stanolind

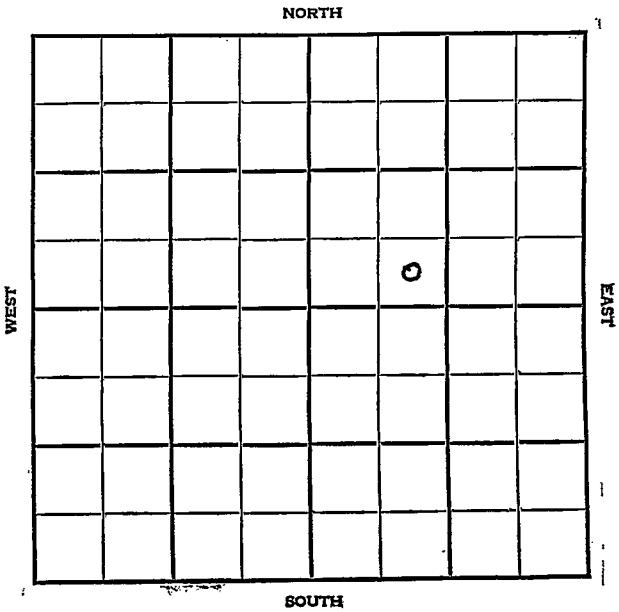

Kingman KANSAS

SEC. 22	TWP. 30	R. 8W ✓
-------------------	-------------------	-------------------

WELL NO. **1 C. J. Boyle "H"** FARM

COMPANY **Stanolind**

CONTRACTOR **Herndon Drlg.**


Spivey Pool

_____ Ft. from N. Line

330 _____ Ft. from S. Line

_____ Ft. from E. Line

990 _____ Ft. from W. Line

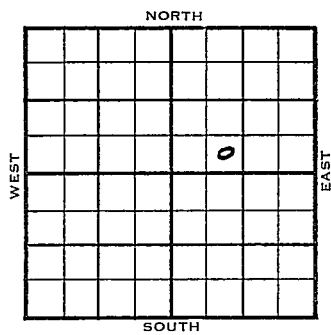

SE SW NE

	ELEVATION	REPORT
1954	1591'	
6/15		spdg 6-10-54 8" @ 219 WOC
6/23		Miss 4244 Drlg. 4280'
7/21		Spud 6-10-54 Oil Well TD 4400' 8" @ 219' Miss 4244' DST 4244-80', opn 1 hr., rec. 75' mud 1530# DST 4280-4315', opn 1 hr., rec. 100' gcm, 1540# DST 4315-50', opn 1 hr., rec. 20' mud, O# DST 4350-4400', opn 1 hr., rec. 30' mud 135# DST 4300-4400', opn 2 hrs., rec. 65' mud, 1080# TD 4400' 5" @ 4399' 40/4308-18, frac., 7½ biph 40% wtr. Comp. 111 bopd

COMPLETED

County Kingman State Kansas

Sec. 22 (Blk. Twp.) 30 (Sur. Rge.) 8W Map No.

Operator Stanolind

Well No. 1 Farm C. J. Boyle "H"

Elev. Location SE SW NE



330 Ft. From S Line NE

990 Ft. From W Line. Quarter

Ist. Report JUN 15 1954

Completion

Remarks

Herndon Drlg. - Contr.

Spudding Date 6-10-54

Drlg. Data Spivey Pool

8" @ 219 WOC

