

Section 22 Township 30s Range 8W

Well No. #1 Rall⁴²

Company Magnolia

NORTH

							0

WEST

EAST

SOUTH

Sec. 22 Twp. 30 R. 8 W

Well No. # 1 Rall Farm

Magnolia Pet. Company

Spivey Pool Contractor


990 Ft. from N. Line

_____ Ft. from S. Line

330 Ft. from E. Line

_____ Ft. from W. Line

SE NE NE

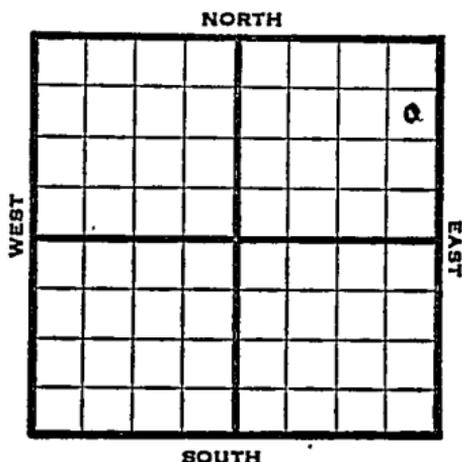

1952

Elev. 1539' REPORT

1/2 Location

2/6 Viola 4553
DST 4554-63 , 1 hr. 56' OCM
555# BHP TD 4563
6-5/8" @4555 DP

2/13 CO to TD A 1000 S/ 2 BSW ph &
scum oil Fishing bailer

2/20 Fish out Set pkg 4234
48/4198-4214 test wtr 2000#
B/2 gal oil & 15 gal wtr 1 hr.
Hyd. SI load

3/5 2000 A S&B 1/2 Bot 3 1/2 BSW ph for
6 hrs. Sq perfs DO 3834
24/3792-3800 NS. 24/3804-10 NS
12/3812-16 NS 36/3819-29 NS
3000 A S/3 BSWPH & SG&O
To sq off

3/12 Sq perfs CO at 3900'

3/19 Spud 1-4-52
Gas well TD 4563' 13" @ 195
Lans. 3420'
DST 3795-3817 open 1 hr. rec 62' SOCM
DST 3848-54 open 1 hr. rec 90' O &
GCM.

DST 3877-94 open 1 hr. 600,000 gas
275' HO & GCM, 100' water.

OVER

1952
3/19

Spud 1-4-52
Gas well TD 4563'
13" @ 195' Lans. 3420'
DST 3795-3817 open 1 hr, rec 62'
SOCM
DST 3848-54 open 1 hr. rec 90' 0 &
GCM
DST 3877-94 open 1 hr, 600,000 gas,
275' HO & GCM, 100' water
Miss 4201' Viola 4553'
DST 4554-63 open 1 hr, rec 56' OCM
TD 4563' 6-5/8" @ 4555 CO to TD
1000 A S/2 BSWPH scum oil DP 4234'
48/4198-4214 water 2000 A
B/2 GO 15 GW 1 hr. Hydro
S/load S/25 BSWPH 10 hr.
SP 3900 16/3776-80 water
16/3880-84 B/5 GWPB 2000 A
F/6 $\frac{1}{2}$ M gas SP 3865' 24/3845-52
dry 24/3852-58 water 2000 A
S & B/1 $\frac{1}{2}$ BO 3 $\frac{1}{2}$ BSWPH 6 hr. DP 3834'
24/3792-3800 24/3804-10 12/3812-16
36/3819-29 3000 A S/3 BSWPH
CO to 3900
Comp. shut in gas well
F/3,500,000 gas

COMPLETED

455.3
1537
3014

County Kingman State Kansas

Sec. 22 (Blk. Twp.) 30 (Sur. Rge.) 8W Map No.

Operator Magnolia Pet.

Well No. 1 Farm Rail

Elev. _____ Location SE NE NE

990 Ft. From N Line NE

330 Ft. From E Line Quarter

lst. Report JAN 2 1952

Completion _____

Remarks _____

Spudding Date _____

Drig. Data Spivey Pool

Location

JAN 8 1952

Scout Cards
Land Small Map
Land Wall Map
Tracings
France Map
Pierce Map
Misc.

Orig. Data

Drig. Date

dry 24 / 3852-58 water 2000 A

S & B / $\frac{1}{2}$ bo $2\frac{1}{2}$ bswph 6 hr. DP 3834

24 / 3792-3800 24 / 3804-10 12 / 3812-16

36 / 3819-29 3000 A S / 3 bswph

GO to 3900 Comp. shut in gas well

F / 3,500,000 gas

Misc.

Pierce Map

France Map

Tracings

Land Wall Map

Land Small Map

Scout Cards *mm*

MAR 25 1952