


Kingman KANSAS

SECTION 22 TOWNSHIP 30 RANGE 8 W

WELL NO. #1 F. D. Rall

COMPANY Stanolind

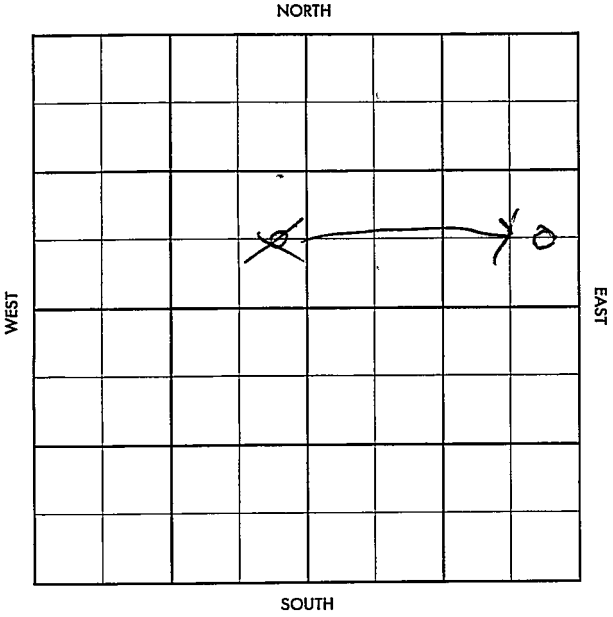

Kingman

KANSAS

SEC. 22	TWP. 31 30	R. 8W
------------	--------------------------	----------

WELL NO.

#1 F.D. Rall

FARM

COMPANY

Stanoline

CONTRACTOR

Barbour

Spivey

Ft. from N. Line


700

Ft. from S. Line

100

Ft. from E. Line

Ft. from W. Line

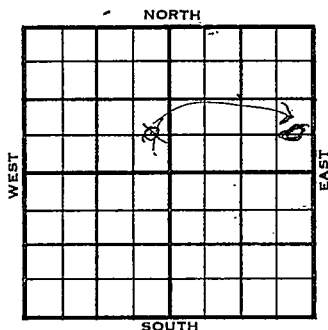C E $\frac{1}{2}$ SE ~~NW~~ NE

1955	ELEVATION 1524	REPORT
------	-------------------	--------

12-21 Comm. 12-13-55
10" @ 204/250
Drlg. 3180
For SWD well

1956

1-18 7" @ 4753/600
CO to 550 0
5000 A
Comp. SWD well
500 BW

Missouri		3404
M.	4172	4194
Sh.		4429
V.	4530	4534
S.		4578
A.	4694	4696
TD 5500'		

ABANDONED

County Kingman Elev. 1524
 Sec. 22 Twp. 30 Rge. 8W
 Company Stanolind
 Farm Name F. D. Rall No. 1

TOPS	DEPTH	LOG	DATUM
Anh.			
Tp.			
H.			
Tr. <u>Missouri</u>		<u>3404</u>	
Dg.			
Bl.			
L.			
K.C.			
B.K.C.			
Ce.			
C.			
M.	<u>4172</u>	<u>4194</u>	<u>2670</u>
M.			
K. <u>sh</u>		<u>4429</u>	<u>2905</u>
Mz.			
Ma.			
V.	<u>4530</u>	<u>4534</u>	<u>3010</u>
S.		<u>4578</u>	<u>3054</u>
S.			
A.	<u>4694</u>	<u>4696</u>	<u>3172</u>
R.			
PE.			
G.			
T.D.	<u>5500</u>		

Loc. in Sec. C E $\frac{1}{2}$ SE NE

Geol. _____
 Contr. Barbour

Pool Spivey

ABANDONED

Date Comm. 12-13-55 JAN 1 8 1956

10" @ 204/250 7" @ 4753/600

GO to 5500 5000 A

Comp. SWD well 500 bw

Co.
Lsc.
No.
Sec.
T.
R.