

KANSAS


Summer

FORM 51 5M 1-42 PETROL

Section 22 Township 30 Range 1 W

Well No. #1 Nixon

Company M. J. Sullivan

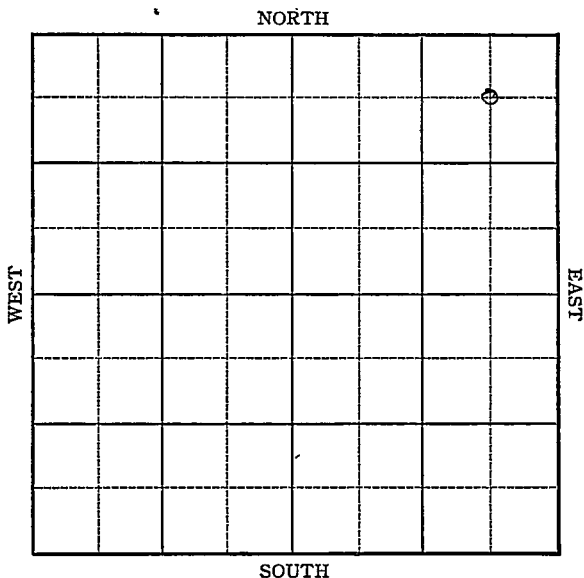

KANSAS

Summer

Sec. 22 Twp. 30 R. 1W

Well No. #1 Nixon Farm

M. J. Sullivan Company

Zyba


C NE NE

660 Ft. from N. Line

 Ft. from S. Line

660 Ft. from E. Line

 Ft. from W. Line

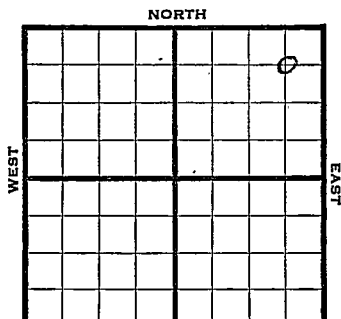

Elev. 1276 *offsets - Snyder - Farm*

REPORT *All-Ready Leased*

1944

5/10	10" 227
	Drlg. 340'
5/17	Drlg. 1186
5/24	Drlg. 2610
5/31	Lens 2896
	SO 3001-06
	Drlg. 3370
6/7	Miss. 3505
	Drlg. 3811
6/15	Simp Sd 3917-25 TD
	SSQ Run 5"
6/21	5" @ 3917-29 TD
	Flow by heads 135 bbls oil total.
6/28	" " " " " "
7/12	" " " " " "
8/19	" " " " " "
7/26	" " " " " "
8/9	Simp sd 3917
	5" @ 3917.
	Flow 210 Pot.
	Grav. 44.0

TD 3929


COMPLETED

KANSAS

Pool Name ZybaMap No. 38 Sec. 22 Twp. 30 R. 1WWell No. 1 NixonM. J. Sullivan CompanyFIRST REPORT Contractor

C NE NE

SECTION PLAT

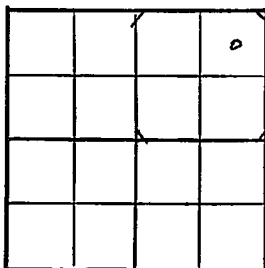660 Ft. from N. Line Ft. from S. Line660 Ft. from E. Line Ft. from W. LineSumner CountyLocation Rig up

Drilling and Remarks:

10" - 227Drlg. 340

RECORD

Cased in., ft.Sand Gas Oil Total Depth

PRODUCTION

1st 24 hrs. Nat. 1st 24 hrs. after shot Gas Cu. Ft.Dry Hole Abandoned

Date

MAY 10 1944 19 S. J. LEWIS Scout

Pool Name ZybaMap No. 22 Sec. 30 Twp. 1WWell No. 1 NixonM. J. Sullivan

Company

COMPLETED

Contractor

C NE NE

SECTION PLAT

660 Ft. from N. Line Ft. from S. Line660 Ft. from E. Line Ft. from W. Line

			o

Sumner County

Location Rig up

Drilling and Remarks:

*Sing Sol 3917**5" 3917**Flow 210/87**442 Gr*

RECORD

Cased in., ft.Sand Gas Oil Total Depth 3929

PRODUCTION

1st 24 hrs. Nat. 1st 24 hrs. after shot Gas Cu. Ft.Dry Hole Abandoned

Date

AUG 9 1944 19

S. J. LEWIS

Scout