FORM 51 25M 3-49 PETROL


KANSAS Grant

Section 22 Township 30 Range 38 W

Well No. 1 Schmidt

Company ~~Hugoton Prod.~~

Hugoton

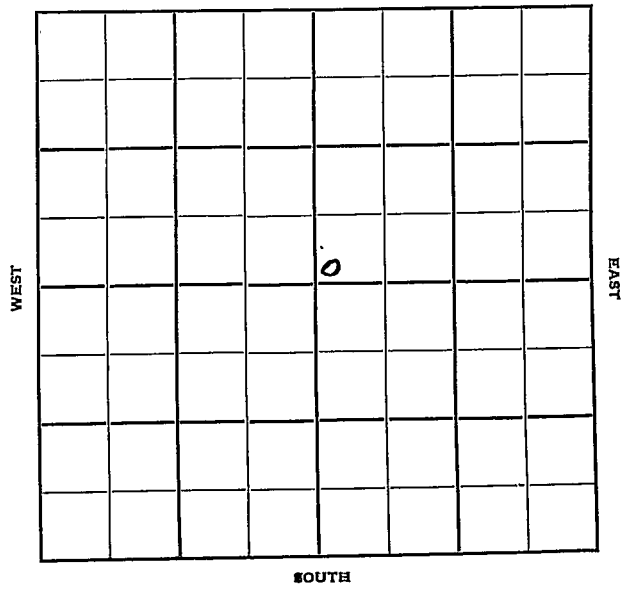

FORM 252-A
5M 10-48 PETROL

KANSAS Grant

Sec. 22 Twp. 30 R. 38W

Well No. #1 Schmidt Farm

Hugoton Prod. Company

Hugoton Pool (Burris, Cont.)


_____ Ft. from N. Line

100' Ft. from S. Line

_____ Ft. from E. Line

100' Ft. from W. Line

SW NE

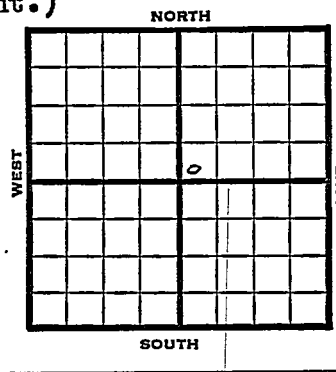

1949	REPORT
6/22	Location
6/28	"
7/6	10"@ 605' Drlg 1804'
7/12	TD 2425' 7" @ 2417'
7/20	TD 2662 258' of 5" Perf Liner @ 2662
7/27	"
8/3	"
8/10	TD 2662' 7"@ 2417' 258' of 5" Perf Liner @ 2662' 1,136,000 Gas 428# R Pr. Comp

COMPLETED

Form 26 200 Bks. 9-48 Petrol

Kansas

Hugoton Pool

Map No. _____ Sec. 22 Twp. 30 R. 38W

Well No. 1 Schmidt


Hugoton Prod. Company

Burris Contractor

SW NE

FIRST REPORT

SECTION PLAT

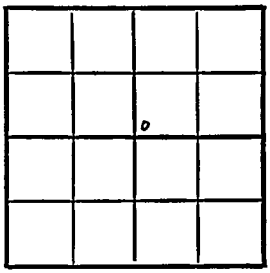

_____ Ft. from N. Line

100 Ft. from S. Line

_____ Ft. from E. Line

100 Ft. from W. Line

Grant County

Location X

Rig up

Drilling and Remarks:

RECORD

Cased _____ in., _____ ft.

Sand

Gas

Oil

Total Depth

PRODUCTION

1st 24 hrs. Nat.

1st 24 hrs. after shot

Gas _____ Cu. Ft.

Dry Hole

Abandoned

Date

JUN 2 2 1949 19

S. J. LEWIS Scout

Form 26 200 Bks. 6-49 Petrol

Kansas

Hugoton Pool

Map No. 1 Sec. 22 Twp. 30 R. 38W

Well No. 1 Schmidt


Hugoton Prod. Company

COMPLETE Contractor

SW NE

E 1,3136

SECTION PLAT

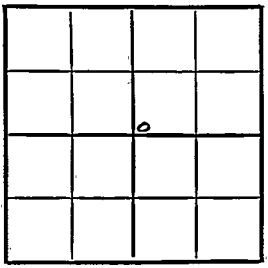

____ Ft. from N. Line

100 Ft. from S. Line

____ Ft. from E. Line

100 Ft. from W. Line

Grant County

Location

Rig up

Drilling and Remarks:

7" @2417

258 sx 5 Perf Liner @2662

1,136,000 Mcf

4/28 * R/P

RECORD

Cased ____ in., ____ ft.

Sand

Gas

Oil

Total Depth 2662

PRODUCTION

1st 24 hrs. Nat.

1st 24 hrs. after shot

Gas Cu. Ft.

Dry Hole

Abandoned

Date

AUG 10 1949 19

S. J. LEWIS Scout