
DX 78-1

Kingman KANSAS

Section 22 Township 30 Range 8W

Well No. 2 Boyle "E"

Company Pickrell Drlg. Co.

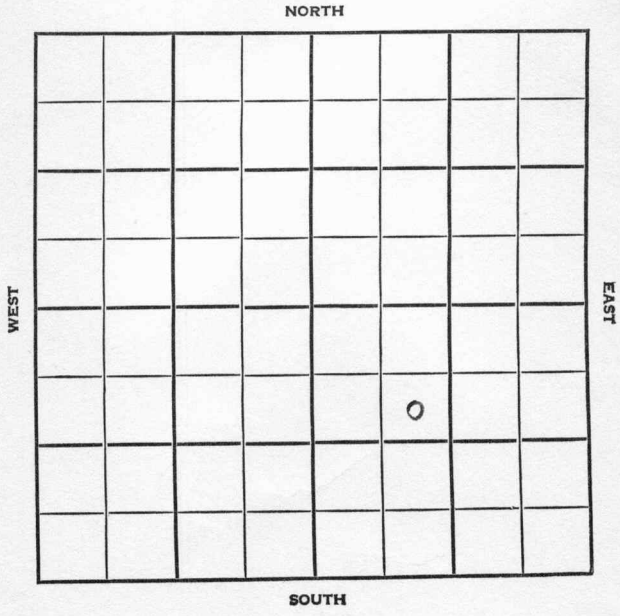

Kingman KANSAS

SEC.	TWP.	R.
22	30	8W

WELL NO.

2 Boyle "E" FARM

COMPANY

Pickrell Drlg. Co.

CONTRACTOR

Co. Tools


Spivey Pool

990 Ft. from N. Line

Ft. from S. Line

Ft. from E. Line

990 Ft. from W. Line

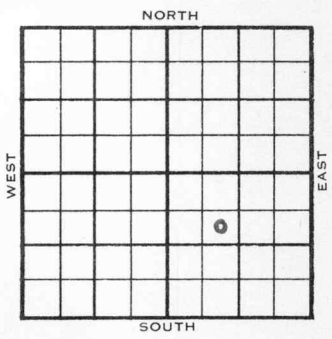

SE NW SE

	ELEVATION	REPORT
1954	1568'	
9/22	Spud 9-17-54 8" @ 120' Drlg. 2200'	
12/15	Spud 9-17-54 SI gas well TD 4350 8" @ 120 Miss 4235 TD 4350 5" @ 4349 Lans 3452 CO to 4317 16/4292-96 B/l BFPH 50% oil 48/4288-96 frac. Comp. SI gas well 6,000,000 CFGPD	
	COMPLETED	

DX-78

FORM 275 FOR SALE BY KANSAS BLUE PRINT CO.

County Kingman State Kansas

Sec. 22 (Blk. Twp.) 30 (Sur. Rge.) 8W Map No.

Operator Pickrell Drlg. Co.

Well No. 2 Farm Boyle "E"

Elev. Location SE NW SE



990 Ft. From N Line SE

990 Ft. From W Line Quarter

1st. Report SEP 22 1954

Completion

Remarks

Co. Tools

Spudding Date 9/17/54

Drlg. Data Spivey Pool

8" @ 120, Drlg 2200

FABEN GILSTRAP

FORM 275 FOR SALE BY KANSAS BLUE PRINT CO.


County Kingman State Kansas

Sec. 22 (Blk. Twp.) 30 (Sur. Rge.) 8W Map No.

Operator Pickrell Drlg.

Well No. 2 Farm Boyle "E"

Elev. 1568 Location SE NW SE

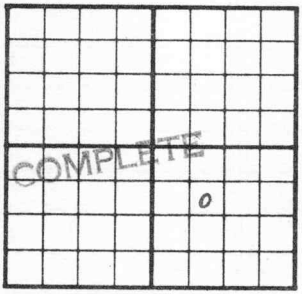

990 Ft. From N Line SE

990 Ft. From W Line Quarter

1st. Report

Completion DEC 15 1954

Remarks Spivey Pool Co. tools

Spudding Date 9-17-54

Drlg. Data SI gas well TD 4350

8" @ 120 Miss. 4235 TD 4350 5" @ 4349

Lans. 3452 CO to 4317 16/ 4292-96

B/ 1 bfph 50% oil 48/ 4288-96

frac Comp. SI gas well 6,000,000 cfgpd

FABEN GILSTRAP