

KANSAS

IMPORTANT
Kans. Geo. Survey request
samples on this well.

REC'D AUG 13 1980

**WELL COMPLETION REPORT AND
DRILLER'S LOG**

S. 2 T. 30S R. 3W E
Loc. apex NE NE SW
County Clark

API No. 15 — 025 — 20,390
County Number

Operator
Oil Property Management, Inc.

Address
221 North Main, Suite 200, Wichita, Kansas 67202


Well No. 2 Lease Name
Pyle Ranch 'B'

Footage Location
1640 feet from X (N) (S) line 1650 feet from X (E) (W) line

Principal Contractor
DaMac Drilling, Inc. Geologist
Al Siemens

Spud Date 8-4-80 Date Completed 8-20-80 Total Depth 5378 P.B.T.D.

Directional Deviation
NA Oil and/or Gas Purchaser
D&A

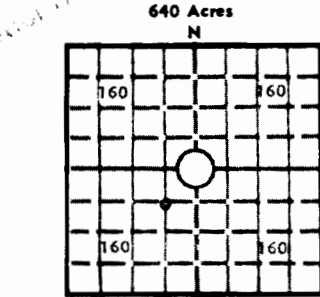

Elev.: Gr. 2462
DF KB 2473

CASING RECORD

Report of all strings set — surface, intermediate, production, etc.

Purpose of string	Size hole drilled	Size casing set (in O.D.)	Weight lbs/ft.	Setting depth	Type cement	Sacks	Type and percent additives
Surface		8-5/8"		756		450 SX	

LINER RECORD

PERFORATION RECORD

Top, ft.	Bottom, ft.	Sacks cement	Shots per ft.	Size & type	Depth interval

Size	Setting depth	Pecker set at

ACID, FRACTURE, SHOT, CEMENT SQUEEZE RECORD

Amount and kind of material used	Depth interval treated

INITIAL PRODUCTION

Date of first production <u>Dry & Abandoned</u>	Producing method (flowing, pumping, gas lift, etc.)
RATE OF PRODUCTION PER 24 HOURS	Oil bbls. Gas MCF Water bbls. Gas-oil ratio CFPB
Disposition of gas (vented, used on lease or sold)	Producing interval (s)

INSTRUCTIONS: As provided in KCC Rule 82-2-125, within 90 days after completion of a well, one completed copy of this Drillers Log shall be transmitted to the State Geological Survey of Kansas, 4150 Monroe Street, Wichita, Kansas 67209. Copies of this form are available from the Conservation Division, State Corporation Commission, 245 No. Water, Wichita, Kansas 67202. Phone AC 316-522-2206. If confidential custody is desired, please note Rule 82-2-125. Drillers Logs will be on open file in the Oil and Gas Division, State Geological Survey of Kansas, Lawrence, Kansas 66044.

erator

Oil Property Management, Inc.

DESIGNATE TYPE OF COMP.: OIL, GAS, DRY HOLE, SWDW, ETC.:

Well No. 2	Lease Name Pyle Ranch 'B'	Dry Hole
---------------	------------------------------	----------

S 2 T 30S R 23W E W

WELL LOG

Show all important zones of porosity and contents thereof; cored intervals, and all drill-stem tests, including depth interval tested, cushion used, time tool open, flowing and shut-in pressures, and recoveries.

SHOW GEOLOGICAL MARKERS, LOGS RUN, OR OTHER DESCRIPTIVE INFORMATION.

FORMATION DESCRIPTION, CONTENTS, ETC.	TOP	BOTTOM	NAME	DEPTH
Attached				

USE ADDITIONAL SHEETS, IF NECESSARY, TO COMPLETE WELL RECORD.

Date Received	<i>Daphne C. Starn</i>
	Signature
	Title
	October 15, 1980
	Date

WELL LOG

State Geological Survey
WICHITA, BRANCH

COMPANY Oil Property Management

SEC. 2 T. 30S R. 23W

FARM Pyle Ranch NO. B 2


LOG. NE NE SW

TOTAL DEPTH 5378

COUNTY Clark

COMM. 8-4-80 COMP. 8-20-80

CONTRACTOR DaMac Drilling Inc.

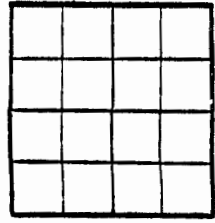

CASING 8 5/8 set @ 756

ELEVATION

PRODUCTION P&A

FIGURES INDICATE BOTTOM OF FORMATIONS

Surface Sand	0	424
RedBed, Shale	424	1378
Lime, Shale	1378	5378 RTD