

Barber


FORM 51 5M PETROL

KANSAS

Section 23 Township 30 Range 15W

Well No. #1 Lott

Company Pryor & Lockhart

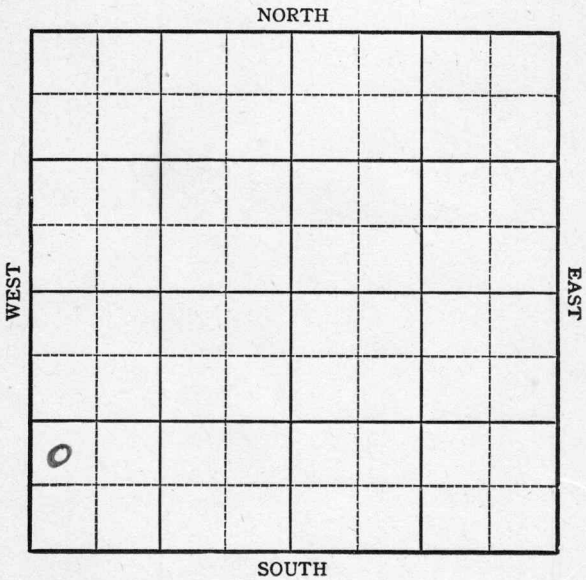


Sec. 23 Twp. 30 R. 15-WWell No. #1 Lott FarmPryor & Lockhart Company

Sun City

 Ft. from N. Line990 Ft. from S. Line Ft. from E. Line330 Ft. from W. Line

NW SW SW

NORTH

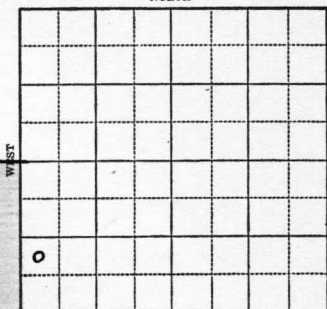

SOUTH

1944

R E P O R T

1896

2/17

Location (Telegram)

2/23

"

3/1

13" @ 184
700 run 10" Csg.

3/8

Drlg. 2400'

3/15

10" @ 926
Drlg. 3575

3/2 2

Lans 4010
TD 4355
HFW
SD

3/29

Lans 4010
Viola 4590
TD 4615

ABANDONED

KANSAS

Map No. 72 Sec. 23 Twp. 30 R. 15WWell No. 1 LottPryor & Lockhart CompanyFIRST REPORT Contractor

NW SW SW

SECTION PLAT

o			

 Ft. from N. Line990 Ft. from S. Line Ft. from E. Line330 Ft. from W. LineSun City PoolLocation XRig up

Drilling and Remarks:

RECORD

Cased in., ft.Sand Gas Oil Total Depth

PRODUCTION

1st 24 hrs. Nat. 1st 24 hrs. after shot Gas Cu. Ft.Dry Hole Abandoned

Date

FEB 23 1944

19

S. J. LEWIS Scout

KANSAS

Map No. 92 Sec. 23 Twp. 30 R. 15WWell No. 1 LottPryor & Lockhart

Company

ABANDONED

Contractor

NW SW SW

SECTION PLAT

o			

Ft. from N. Line

990

Ft. from S. Line

Ft. from E. Line

330

Ft. from W. Line

Sun City Pool

Location

Rig up

Drilling and Remarks:

*Lane 4010**Vista 4590*

RECORD

Cased _____ in., _____ ft.

Sand _____

Gas _____

Oil _____

Total Depth 4615

PRODUCTION

1st 24 hrs. Nat. _____

1st 24 hrs. after shot _____

Gas _____ Cu. Ft.

Dry Hole _____

Abandoned _____

Date

MAR 29 1944

19

S. J. LEWIS

Scout