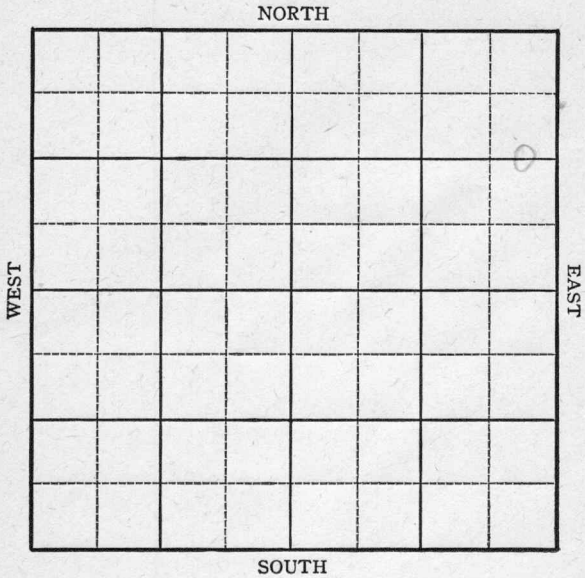


FORM 51 5M PETROL


Section 23 Township 30 Range 35WWell No. 1 Taylor KleinCompany United Prod.

KANSAS

Grant

Sec. 23 Twp. 30 R. 35-WWell No. #1 ~~Taylor~~ Klein FarmUnited Prod. Company1320 Ft. from N. Line Ft. from S. Line100 Ft. from E. Line Ft. from W. Line

C' E L N E Elev. 2888

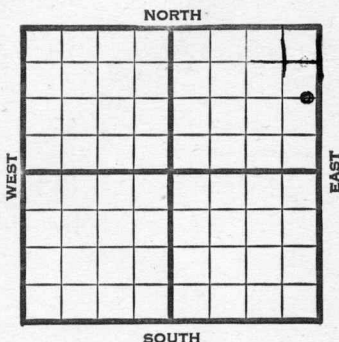

1945

REPORT

8/8 10" @ 491' WOC

8/15 TD 2510
7" @ 2510 RUST8/22 TD 2715
214' of 5" perf. liner @ 2715

8/29 " " " " "

9/5 " " " " "

9/12 " " " " "

9/19 8000 acid.

9/26 " "

10/3 " "

10/10 7" @ 2510

214' of 5" Perf. liner @ 2715

8000 acid.

TD 2715'

10,762,000 Gas

410# R Pr.

COMPLETED

KANSAS Pool Name HugotonMap No. 23 Sec. 23 Twp. 30 R. 35WWell No. 1 TaylorUnited Prod.

Company

FIRST REPORT

Contractor

C E. L. NE


SECTION PLAT

1320 Ft. from N. Line

Ft. from S. Line

100 Ft. from E. Line

Ft. from W. Line

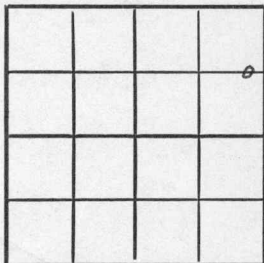Grant County

Location

Rig up

Drilling and Remarks:

10" 491 WOC

RECORD

Cased _____ in., _____ ft.

Sand _____

Gas _____

Oil _____

Total Depth _____

PRODUCTION

1st 24 hrs. Nat. _____

1st 24 hrs. after shot _____

Gas _____ Cu. Ft.

Dry Hole _____

Abandoned _____

Date

AUG 8 1945

19

S. J. LEWIS

Scout

KANSAS

Kansas Pool Name HugotonMap No. 20 map Sec. 23 Twp. 30 R. 35WWell No. 1 KleinUnited Prod.

Company


COMPLETED

Contractor

C E L N E

E 1,288'

SECTION PLAT

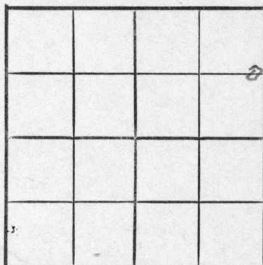1320 Ft. from N. Line Ft. from S. Line100 Ft. from E. Line Ft. from W. Line

Grant County

Location Rig up

Drilling and Remarks:

7" @ 2570
 2 1/4" x 5" Pay line
 @ 2715
 5000 acal
 10, 962,000 Gas

410 # R 1/2

RECORD

Cased in., ft.Sand Gas Oil Total Depth 2715

PRODUCTION

1st 24 hrs. Nat. 1st 24 hrs. after shot Gas Cu. Ft.Dry Hole Abandoned

Date

OCT 10 1945 19S. J. LEWIS

Scout