
FORM 51 10M 7-48 PETROL

KANSAS Grant

Section 23 Township 30 Range 36W

Well No. 5 Teters

Company United Prod.

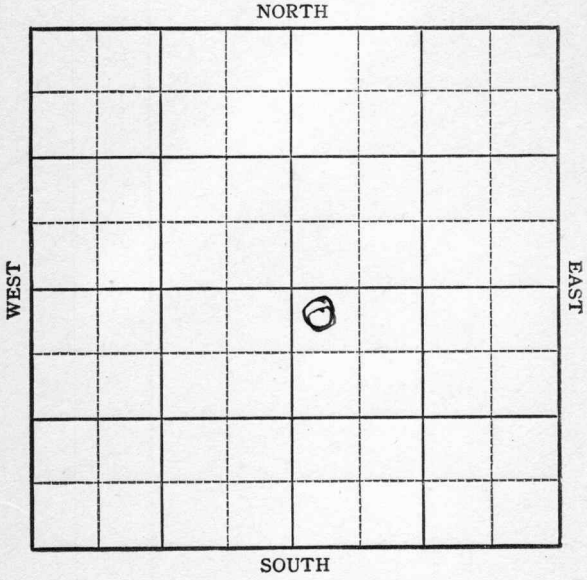

FORM 252-A
5M 4-48 PETROL

KANSAS Grant

Sec. 23 Twp. 30 R. 36W

Well No. #5 Teters Farm

United Prod. Company

Hugoton Pool


100' Ft. from N. Line

_____ Ft. from S. Line

_____ Ft. from E. Line

100' Ft. from W. Line

NW SE

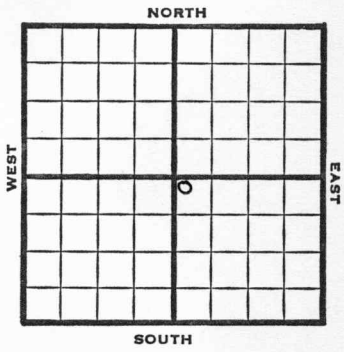

1948	Eli 2932' REPORT
7/28	Location
8/4	10" @ 472' TD 2443' 7" @ 2440'
8/11	"
8/18	TD 2647'
8/25	2000 acid
9/1	12,000 acid
9/8	"
9/14	"
9/21	"
9/29	TD 2647' 7"@ 2440' 14000 acid 12,100,000 gas 399# R PR. Comp

COMPLETED

Form 27—100 Bks.—4-48—Petrol

Grant County Kansas State

Map No. Sec. 23 Twp. 30 R. 36W


Well No. 5 Teters

United Prod. Company

FIRST REPORT Contractor

NW SE

SECTION PLAT

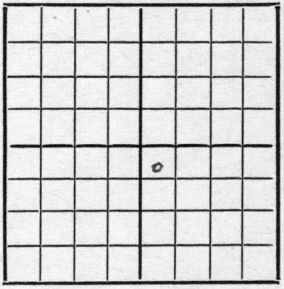

100 Ft. from N. Line

Ft. from S. Line

Ft. from E. Line

100 Ft. from W. Line

Hugoton Pool

Remarks:

Location

Date JUL 2 8 1948

Scout S. J. LEWIS

Form 26—200 Bks.—1-48—Palace

Kansas

Hugoton Pool

Map No. _____ Sec. 23 Twp. 30 R. 36W

Well No. 5 Teters


United Prod. Company

COMPLETE Contractor

NW SE

E 1, 2832

SECTION PLAT

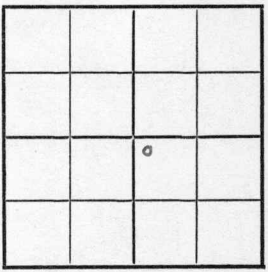

100 Ft. from N. Line

_____ Ft. from S. Line

_____ Ft. from E. Line

100 Ft. from W. Line

Grant County

Location _____

Rig up _____

Drilling and Remarks:

7" @ 2440

1400 acid

12,100,000 Gas

399 # R/P

RECORD

Cased _____ in., _____ ft.

Sand _____

Gas _____

Oil _____

Total Depth 2647

PRODUCTION

1st 24 hrs. Nat. _____

1st 24 hrs. after shot _____

Gas _____ Cu. Ft.

Dry Hole _____

Abandoned _____

Date

SEP 29 1948 19____ S. J. LEWIS Scout