


Section 23 Township 30 Range 9 W

Well No. #1 Defenbusch

Company Cities Service

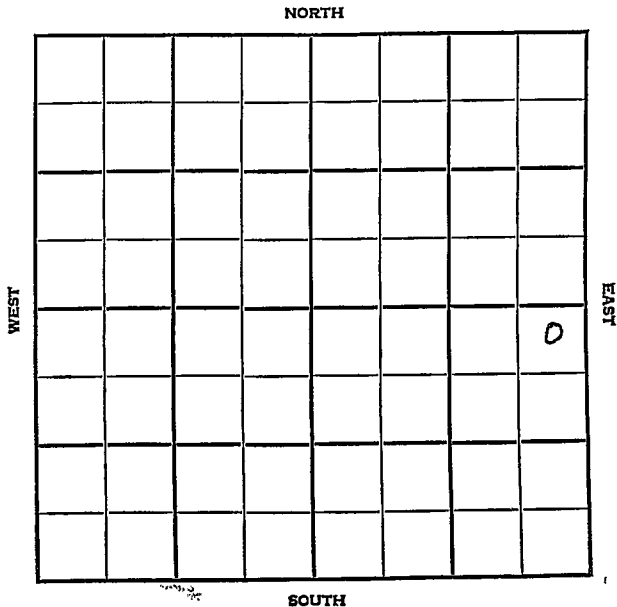

County Kennett Elev. _____

Sec. 23 Twp. 30 Rgs. 9W

Company Cities Service

FarmName Deffenbusch No. 1

TOPS	DEPTH	LOG	DATUM
Anh.			
TP.			
H.			
Tr.			
Dg.			
Bl.			
L.			
K.C.			
B.K.C.			
Ce.			
C.			
M.			
M.			
K.			
Mz.			
Mq.			
V.			
S.			
S.			
A.			
R.			
P.E.			
G.			
T.D.			

Loc. in Sec. NE NE SE

Geol. _____

Contr. _____

Pool _____

Wildcat

FIRST REPORT	
/	o
FEB	8 '56

Date Comm. _____

Location _____

[Handwritten signature]

Co.
Lse.
No.
Sec.
T.
R.

County Kingman Elev. 1567 Co. 1
 Sec. 23 Twp. 30 Rge. 9W
 Company Cities Service
 Farm Name Defenbusch No. 1

TOPS	DEPTH	LOG	DATUM	Loc. in Sec.
Anh.				NE NE SE
Tr.	<u>2912</u>			
H.	<u>3397</u>			
Tr. <u>Dodge</u>	<u>3313</u>			
Dg. <u>sh</u>	<u>3329</u>			
Bl.				
L.	<u>3498</u>		<u>1931</u>	Geol.
K.C.				Contr.
B.K.C.	<u>4018</u>		<u>2451</u>	
Ce.				
C.				
M.	<u>4223</u>		<u>2656</u>	Pool
M. <u>low</u>	<u>4290</u>		<u>2723</u>	
K.	<u>4412</u>		<u>2845</u>	Wildcat
Mz.				
Me.				
V.	<u>4516</u>		<u>2949</u>	<div style="border: 1px dashed black; padding: 5px; text-align: center;"> MAR 28 '56 ABANDONED </div>
S. <u>sk</u>	<u>4577</u>		<u>3010</u>	
S. <u>sk</u>	<u>4580</u>		<u>3013</u>	
A.	<u>4699</u>		<u>3132</u>	
R.				
PE.				
G.				
T.D.	<u>4748</u>			

Date Comm. 3-6-56
8 5/8" @ 313/250 DST 4224-35 open 1 hr.
rec. 2600' gas 150' gc & socm 390#
DST 4235-54 open 1 hr. rec. 160' sgc &
socm 710/30" DST 4255-70 open 1 hr.
gas in 13 min. rec. 55' so & gcm
150' msw 1450/20" DST 4517-22
open 1 hr. rec. 2814' wul. wtr. 1650/20"

D & A