Kingman KANSAS

FORM 51 25M 8-50 WESTERN

Section 23 Township 30 Range 8 W

Well No. # 1 Arnold Mark

Company Magnolia Pet.

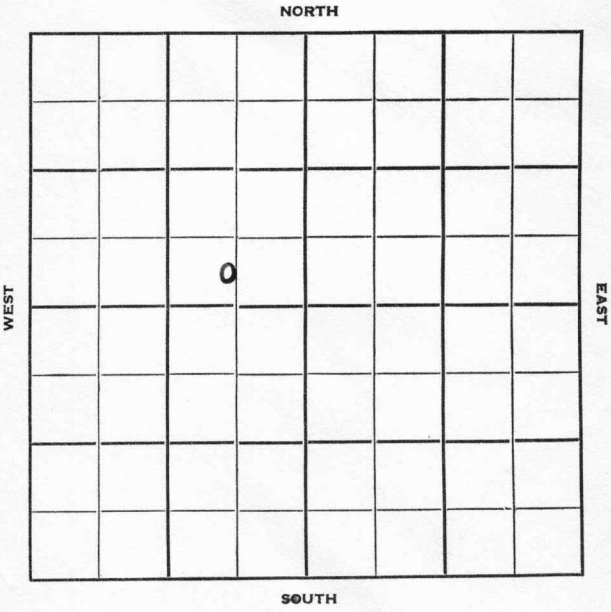

FORM 252-B

Kingman KANSAS ✓

Sec. 23 Twp. 30 R. 8 W

Well No. # 1 Arnold Mark Farm

Magnolia Pet. Company

Barnett Drlg. Contractor

Spivey Pool

Ft. from N. Line

330 Ft. from S. Line

730 Ft. from E. Line

Ft. from W. Line

C S L SE NW

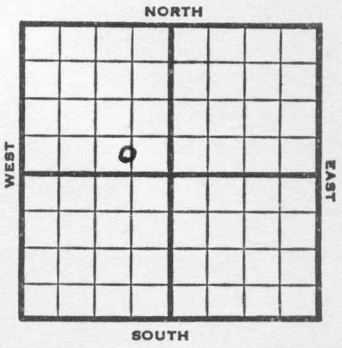

1953	Elev. 1565' REPORT
6/24	Location
7/1	8" @ 221 Drlg. 2050'
7/8	Lans 3441' DST 3450-72, 1 hr, 28' M 840# Drlg. 3725'
7/22	N.R.
8/5	Spud 6-25-53 Oil well TD 4320 8" @ 221 Lans. 3441 DST 3450-72 open 1 hr rec 28' mud 840# DST 3925-40 open 1 hr rec 62' mud 1510# Miss 4223 DST 4225-55, open 1 hr, rec 60' GCM 60' OCM, 60' HOCM, 60' MCO 980# DST 4255-75 open 1 hr rec 120' MCO, 60' HOCM, 60' OCM, 3' wtr. 1170# TD 4320 5" @ 4320 PB 4290 60/4255-70 S/1 BO 10 GWPH 15 hr. St-frac. S/25 BO 3 BWPH 10 hr. P/19 BO 8 BWPD Comp. 182 BOPD 18 BW COMPLETED

FORM 275 FOR SALE BY KANSAS BLUE PRINT CO.

County Kingman State Kansas

Sec. 23 (Blk. Twp.) 30 (Sur. Rge.) 8W Map No.

Operator Magnolia Pet.

Well No. 1 Farm Arnold Mark

Elev. Location C S L SE NW

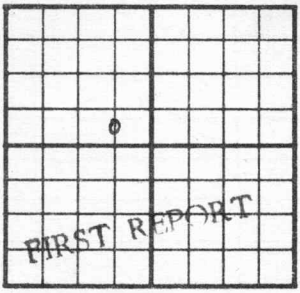

330 Ft. From S Line NW

730 Ft. From E Line Quarter

1st. Report JUN 24 1953

Completion

Remarks Barnett Drlg. - Contr.

Spudding Date

Drlg. Data Spivey Pool

Location

J. G. McGEHEE

FORM 275 FOR SALE BY KANSAS BLUE PRINT CO.

County Kingman State Kansas

Sec. 23 (Blk. Twp.) 30 (Sur. Rge.) 8W Map No.

Operator Magnolia Pet.

Well No. 1 Farm Arnold Mark

Elev. 1565 Location C S L SE NW

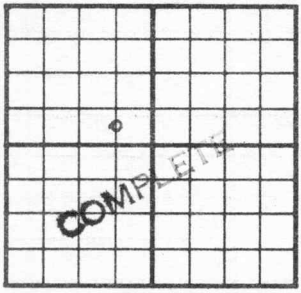

330 Ft. From S Line NW

730 Ft. From E Line Quarter

1st. Report

Completion AUG 5 1953

Remarks Spivey Pool

Barnett Drlg. - Contr.

Spudding Date 6-25-53

Drlg. Data Oil well TD 4320

8" @ 221 Lans. 3441 DST 3450-72

open 1 hr. Rec. 28' mud 840#

DST 3925-40 open 1 hr. Rec. 62' mud

1510# Miss. 4223 DST 4225-55 open 1 hr

Rec. 60' gcm 60' ocm 60' hocm 60' mco

980# DST 4255-75 open 1 hr. Rec.

120' mco 60' hocm 60' ocm 3' wtr.

1170# TD 4320 5" @ 4320 PB 4290

60/ 4255-70 S/ 1 bo 10 gwph 15 hr.

st-frac S/ 25 bo 3 bwph 10 hr.

P/ 19 bo 8 bwpd

Comp. 182 bopd 18 bw

J. G. McGEHEE