
FORM 51 25M 3-49 PETROL Kingman KANSAS

Section 23 Township 30 Range 8W

Well No. #1 Boyle

Company Iron Drlg.

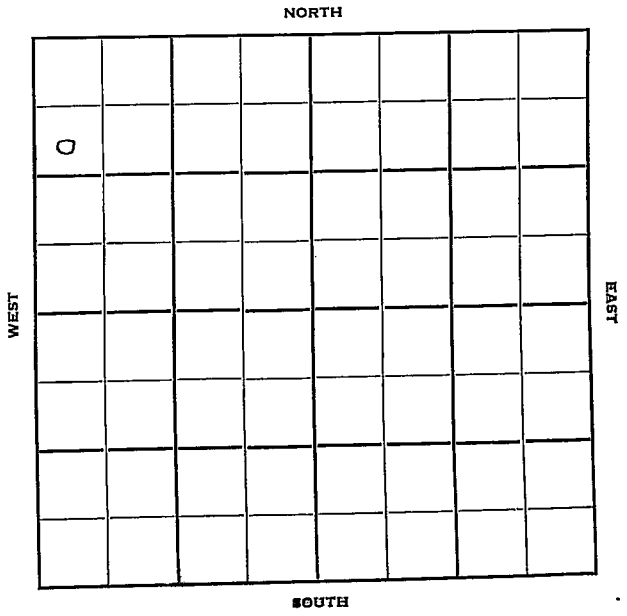

L

FORM 252-B
10M 11-50 PETROL

Kingman KANSAS

Sec. 23 Twp. 30 R. 8W

Well No. #1 Boyle Farm

Iron Drlg. Company

Iron Drlg. - Contr. Contractor

Wildcat


990' Ft. from N. Line

Ft. from S. Line

Ft. from E. Line

330' Ft. from W. Line

SW NW NW

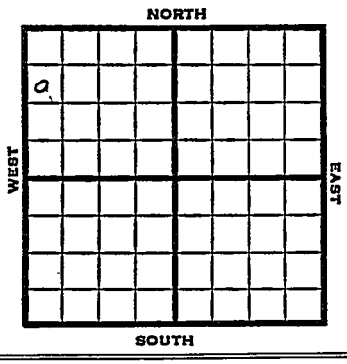

1951	Elev. 1515' REPORT
8/15	13" @ 140 Drlg. 1720'
11/7	Oil Well TD 4765 13" @ 140 Lans. 3407 DST 3858-82 opn 1 hr. gas in 4 min. F/oil & wtr Rec. 390' oil & wcm 210' sw DST 3856-67 opn 1 hr. gas in 3 min. 1,014 mcfg Rec. 270' oil & Wcm Miss 4168 DST 4168-87 opn 1 hr gas in 3 min. 3,140 mcfg DST 4187-4213 opn 1 hr Rec.135' ho & gcm DST 4223-33 opn 1 hr. Rec. 102' ho & gcm Kh. 4391 Viola 4523 Simp 4581 DST 4580-90 opn 1 hr Rec. 710' sw Arb. 4697 DST 4697-4765 opn 1 hr Rec. 3800' sulphur wtr 5" @ 4299 88/4238-60 4000 A S/7½ boph SP 4234 32/4223-31 S/4 bfph 16,000 A DP to 4260 S/4 boph 5% wtr SP 4231 32/4205-13 12/4213-16 CO to 4270 S/3¼ boph 3% wtr P/2½ boph Comp. 270 bopd 2% wtr. COMPLETED

FORM 275 FOR SALE BY KANSAS BLUE PRINT CO.


County Kingman State Kansas

Sec. 23 (Blk. Twp.) 30 (Sur. Rge.) 8W Map No.

Operator Iron Drlg.

Well No. 1 Farm Boyle

Elev. 1515 Location SW NW NW

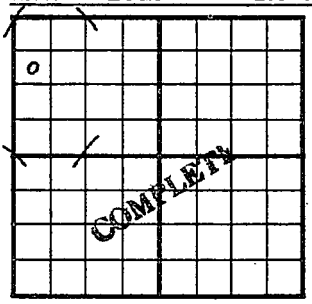

990 Ft. From N Line NW

330 Ft. From W Line Quarter

Ist. Report

Completion NOV 27 1951

Remarks Wildcat

Iron Drlg. - Contr.

Spudding Date

Drlg. Data Oil well TD 4765

13" @ 140 Lans. 3407 DST 3858-82

open 1 hr. gas in 4 min. F/ oil & water

Rec. 390' oil & wcm 210' sw DST 3856-67

open 1 hr. gas in 3 min. 1,014 mcfg

Rec. 270' oil & wcm Miss. 4168

DST 4168-87 open 1 hr. gas in 3 min.

3,140 mcfg DST 4187-4213 open 1 hr.

Rec. 135' ho & gcm DST 4223-33 open 1 hr.

Rec. 102' ho & gcm Kn. 4391 Viola 4523

Simp. 4581 DST 4580-90 open 1 hr.

Rec. 710' sw Arb. 4697 DST 4697-4765

open 1 hr. Rec. 3800' sulphur water

5" @ 4299 88/ 4238-60 4000 A

S/ 7½ boph SP 4234 32/ 4223-31

J. E. TYRA

Drlg. Data

S/ 4 bfph 16000 A DP to 4260

S/ 4 boph 5% water SP 4231 32/ 4205-13

12/ 4213-16 CO to 4270 S/ 3¼ boph 3% wate

P/ 2½ boph Comp. 270 bopd 2% water

Misc.
Pierce Map
Trance Map
Tracings
Land Wall Map
Land Small Map
Scout Cards

NOV 20 1951

FORM 275 FOR SALE BY KANSAS BLUE PRINT CO.


County Kingman State Kansas

Sec. 23 (Blk. Twp.) 30 (Sur. Rge.) 8W Map No.

Operator Iron Drlg.

Well No. 1 Farm Boyle

Elev. Location SW NW NW

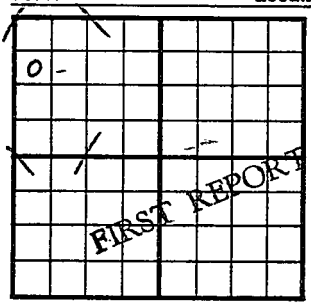

990 Ft. From N Line NW

330 Ft. From W Line Quarter

1st. Report AUG 1 5 1951

Completion

Remarks Magnolia farmout Stanolind DHM

Iron Drlg. - Contr.

Spudding Date

Drlg. Data. Wildcat

13" @ 140 drlg. 1720

J. E. TYRA

Scout Cards
Land Small Map
Land Wall Map
Tracings
France Map
Pierce Map
Misc.

AUG 21 1951

Drlg. Data