

Section 23 Township 30 Range 8 WWell No. # 2 BoyleCompany Pickerell Drlg.

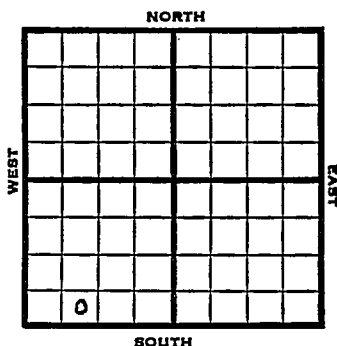
NORTH

WEST

	0						

EAST

SOUTH

Sec. 23 Twp. 30 R. 8WWell No. #2 Boyle FarmPickrell Drlg. CompanyPickrell Drlg. Contractor Ft. from N. Line330. Ft. from S. Line Ft. from E. Line990 Ft. from W. LineSW $\frac{1}{4}$ SE SW SW

1952 Elev. 1600' REPORT

11/19 Spud 11-1552
8" @ 204'
Drlg. 2000'

11/27 Lans 3486
Drlg. 3680'

12/4 DST 3983-93, opn 1 hr., rec.
840' GCM & SW 1830#

12/11 Ø4610

12/18 KH 4533 V 4638 RTD 4685 5" @ 4665 Schl.

12/25 " " " " "

1/1 48/4370 lot oil & serts A-frac POP
1/8 NR

1/22 "

1/29 NR

2/4 Spud 11-15-52
Oil Well
TD 4685
8" @ 204'
Lans 3486
DST 3983-93, opn 1 hr., rec.
840' gcm & sw 1830#

OVER

#2 Boyle

(Information Brought Forward)

1953

2/4

Miss 4286

DST 4287-4315, opn 1 hr., rec.

30' gcm, 315#

DST 4323-33, opn 1 hr., rec.

30' gcm, 315#

DST 4323-33, opn 1 hr., rec.

100' gcm, 28' ocm, 440#

DST 4334-48, opn 1 hr., rec.

210' o& gcm, 430#

DST 4350-86, opn 1 hr., rec.

90' gcm, 390' ho & gcm, 30' sw,

1490#

Miss 4286, Kh 4533, Viola 4638

TD 4685,

5" @ 4665

48/4370-78, A-frac

Comp. 283 bopd 30% wtr.

COMPLETED

County Wichita State Kansas

Sec. 23 (Blk. Twp.) 30 (Sur. Rge.) 8W Map No.

Operator Pickrell D-1g

Well No. 2 Farm Boyle

Elev.	Location	SE	SW	SW
-------	----------	----	----	----

330 Ft. From S Line SW

990 Ft. From **W** Line Quarter

1st. Report NOV 19 1952

Completion _____

Remarks _____

Pickrell Drlg. - Contr

Spudding Date 11-15-52

Drbg. Data

8" @ 204 drlg. 2000

J. G. McGEHEE

Scout Cards	<u>AD</u>
Land Small Map	<u> </u>
Land Wall Map	<u>53</u>
Tracings	<u> </u>
France Map	<u> </u>
Pierce Map	<u> </u>
Misc.	<u> </u>

NOV 21 1952

Drig. Data

Scout Cards _____
Land Small Map _____
Land Wall Map _____
Tracings _____
France Map _____
Pierce Map _____
Misc. _____

FEB 10 1953

Orig. Date