
DX 78-1 Kingman KANSAS

Section 23 Township 30 Range 8 W

Well No. #3 Boyle "C"

Company Pickrell Drlg.

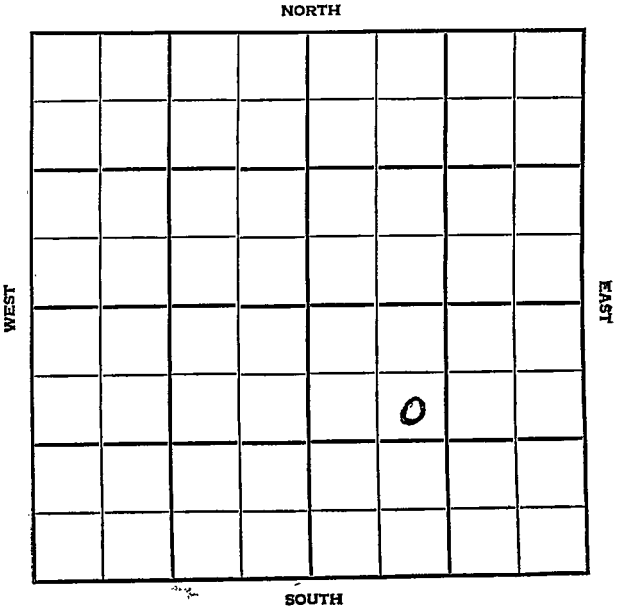

Kingman KANSAS

SEC.	TWP.	R.
23	30	8W

WELL NO.
#3 Boyle "C" FARM

COMPANY
Pickrell Drlg.

CONTRACTOR
Co. Tools

Spivey


_____ Ft. from N. Line

_____ Ft. from S. Line

_____ Ft. from E. Line

_____ Ft. from W. Line

SE NW SE

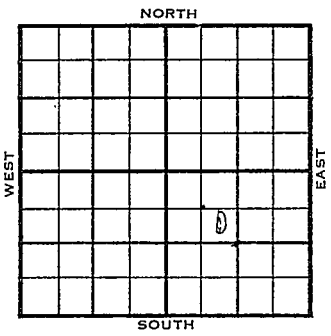

1956	ELEVATION 1606 REPORT
2-8	Comm. 2-7-56
3/28	Comm 2-7-56 M 4339 TD 4438 8 5/8" @ 160/135 5 1/2" @ 4435/100 CO to 4411 40/3 4343-58 frac S/10 boph 6 hr Comp 78 bopd 41% wtr **COMPLETED**

DX-78

FORM 513 REV. SUNRAY

County Kingman Elev.

Sec. 23 Twp. 30 Rge. 8W

Company Pickrell Drlg.

Farm Name Boyle "C" No. 3

TOPS	DEPTH	LOG	DATUM
Anh.			
T.P.			
H.			
Tr.			
Dg.			
Bi.			
L.			
K.C.			
B.K.C.			
Ce.			
C.			
M.			
M.			
K.			
Mz.			
Mo.			
V.			
S.			
S.			
A			
R.			
P€.			
G.			
T.D.			

Loc. in Sec. SE NW SE

Geol.

Contr. Co. tools

Pool Spivey

FIRST REPORT

FEB 8 '56

Date Comm. 2-7-56

Co. Lse. No. Sec. T. R.

FORM 513 REV. SUNRAY

County Kingman Elev. 1606

Sec. 23 Twp. 30 Rge. 8W

Company Pickrell Drlg.

Farm Name Boyle "C" No. 3

TOPS	DEPTH	LOG	DATUM
Anh.			
T.P.			
H.			
Tr.			
Dg.			
Bl.			
L.			
K.C.			
B.K.C.			
Ce.			
C.			
M.	4339		2733
M.			
K.			
Mz.			
Mq.			
V.			
S.			
S.			
A			
R.			
P€.			
G.			
T.D.	4438		

Loc. in Sec. SE NW SE

Geol.

Contr. Co. tools

Pool Spivey

COMPLETE

MAR 28 '56

Date Comm. 2-7-56

8 5/8" @ 160/135 5½" @ 4435/100

CO to 4411 40/ 4343-58 frac

S/ 10 boph 6 hr. Comp. 78 bopd 41% wtr.

Co. Lse. No. Sec. T. R.