

Kingman KANSAS

DX 78-1

Section 23 Township 30 Range 8W

Well No. 2 Gans Brown

Company Stanolind

NORTH

						0			

WEST

EAST

SOUTH

Kingman KANSAS

SEC.	TWP.	R.
23	30	8W

WELL NO. 2 Gans Brown FARM

COMPANY Stanolind

CONTRACTOR Noble Drlg. Co.


Spivey Pool

990 Ft. from N. Line

Ft. from S. Line

990 Ft. from E. Line

Ft. from W. Line

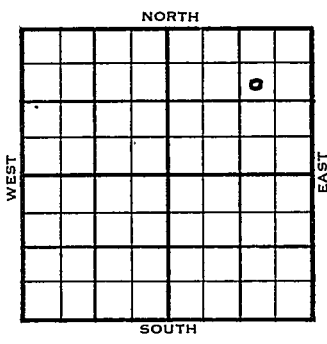

SW NE NE

	ELEVATION	REPORT
1954	1562	

7/14 Spud 7-8-54
8" @ 200'
Drlg. 2302'

7/21 Lans. 3443 Miss 4238
DST 4238
631 Hr. gas 14" 45' So & gcm 90'
SMCO 1500#
Drlg. 4280

8-11- Spdg 7-8-54
Oil well
TD 4335
8" @ 200
Lans. 3443 Miss. 4238,
DST 4238-63 open 1 hr. gas in 14 min.
Rec. 45' so & gcm 90' smco 1500#
DST 4263-80 open 1 hr. Rec. 60' o & gcm
930#
TD 4335
5" @ 4334 CO to 4305 32/ 4242-50
6 go gwph sdpoil-frac F/ 17 bo 1 bwph
Comp. F/ 221 bopd 2% wtr.

COMPLETED

