


Section 23 Township 30 Range 8W

Well No. 2 C. J. Boyle "B"

Company Stanolind

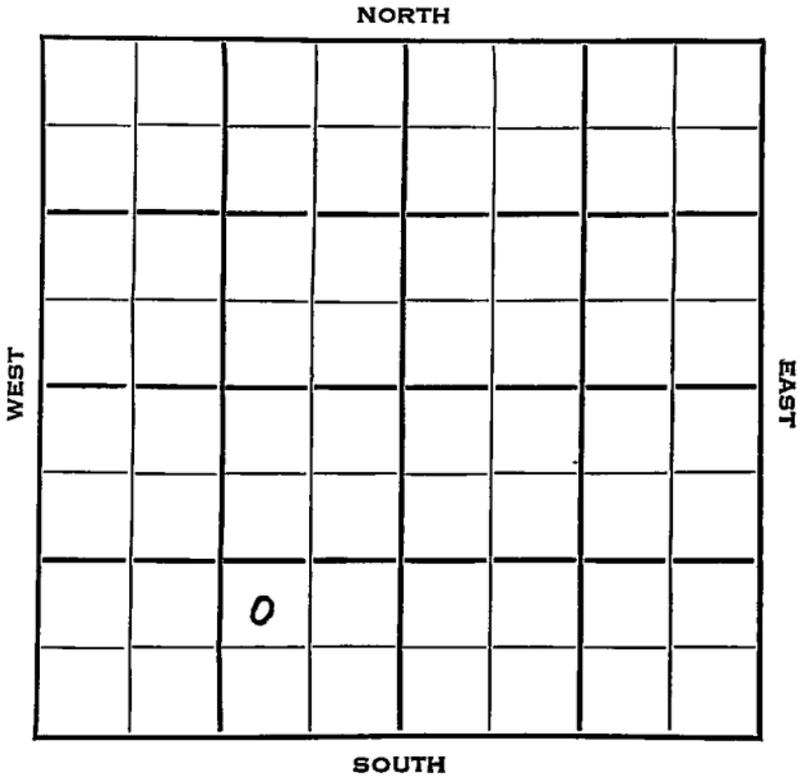

SEC.	TWP.	R.
23	30	8 W
WELL NO.		
# 2 C. J. Boyle "B"		
COMPANY		FARM
Stanolind		
CONTRACTOR		

Spivey Pool


_____ Ft. from N. Line

990 _____ Ft. from S. Line

990 _____ Ft. from E. Line

_____ Ft. from W. Line

NW SE SW

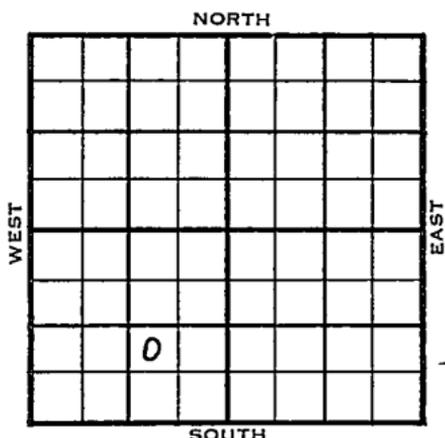

	ELEVATION	REPORT
1954	1590'	
3/10	Spud 3-7-54 10" @ 199 Drlg. 200	
3/17	Drlg 3025'	
3/24	Lans 3486' Drlg 4234'	
4/21	Spud 3-7-54 Oil Well TD 4400' 10" @ 199' Lans 3486', Miss 4275', DST 4275'-95' opn 1 hr, rec 130' sgcm 630# DST 4295'-4320' opn 1 hr, rec 35' socm 65# DST 4320'-45' opn 1 hr, rec 30' so & gcm 270' hocm 180' mco 1300# DST 4345'-70' opn 1 hr, rec 30' o & gcm 180' ho & gcm 90' smco 90' free oil 1365# TD 4400' 7" @ 4399' CO to 4365 64/ 4330-46 16/ 4356-60 S/ 6½ boph frac. 32/ 4330-46 sd-oil-frac Comp 263 bopd 17 bw	

