


Section 23 Township 30 Range 8W

Well No. 1 Gans Brown

Company Stanolind

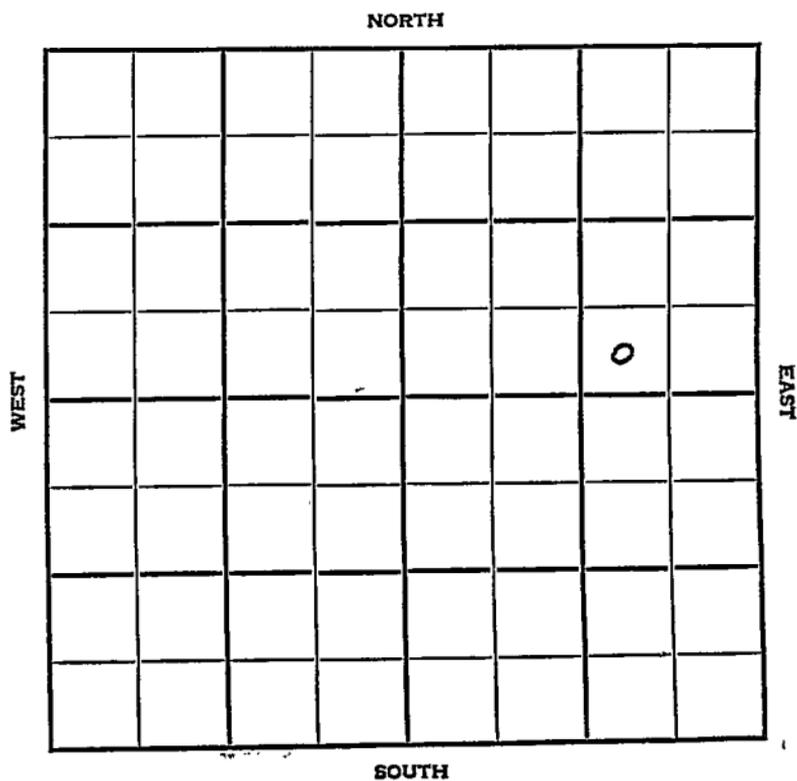

| | | |
|------|------|-----|
| SEC. | TWP. | R. |
| 23 | 30 | 8 W |

WELL NO. # 1 Gans Brown FARM

COMPANY Stanolind

CONTRACTOR Herndon Drlg.

Spivey Pool


_____ Ft. from N. Line

330 _____ Ft. from S. Line

990 _____ Ft. from E. Line

_____ Ft. from W. Line

SW SE NE

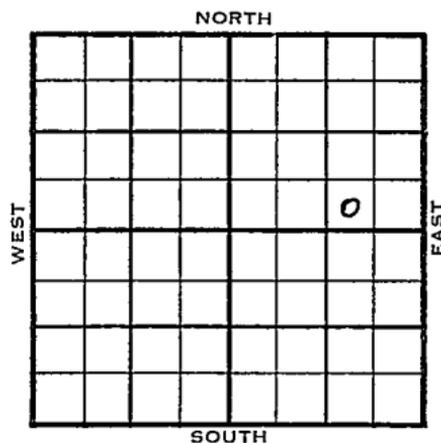

| | ELEVATION | REPORT |
|------|--|--------|
| 1954 | 1582' | |
| 4/27 | Spud 4-22-54 8" @ 199 Drlg. 2285' | |
| 5/5 | Lans 3477' Drlg 4185' | |
| 5/26 | Spud 4-22-54 Oil well TD 4400 8" @ 199 Lans. 3477 Miss 4259 DST 4265-95 open 1 hr rec 485' free oil 270' SM & GCO 150' O & GCM, 20' wtr. 1165# DST 4295-4325, open 1 hr rec 120' free oil, 180' gassy oil, 90' SG & MCO 60' VHO & GCM 1317# DST 4325-90 open 1 hr, rec 60' mud, 30' wtr. 1514# TD 4400 5" @ 4399 CO to 4356 32/4282-90 56/4298-4312 2 BO 1 BWPB sd-oil-frac. F/39 BOPB Comp. 1311 BOPD | |

COMPLETED

