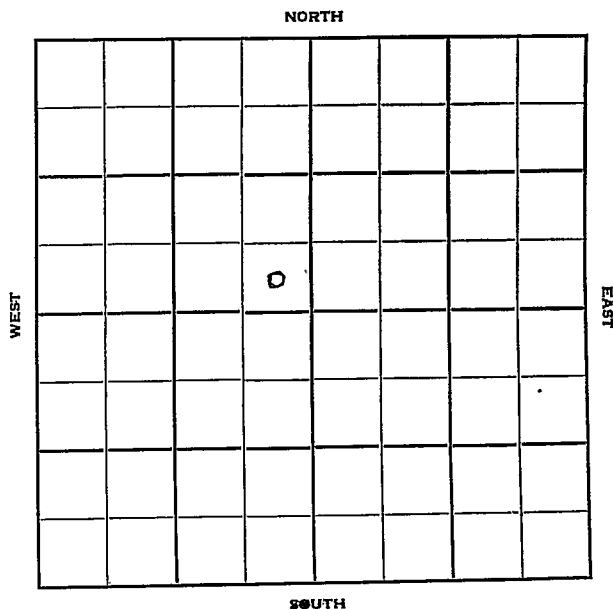


Section 23 Township 30 Range 32WWell No. #1 Cook "D"Company Cities Service

Haskell

KANSAS

Sec. 23 Twp. 30 R. 32 W

Well No. # 1 Cook "D" Farm

Cities Service Company

Contractor

Hugoton Pool


Ft. from N. Line

100 Ft. from S. Line

100 Ft. from E. Line

Ft. from W. Line

SE NW

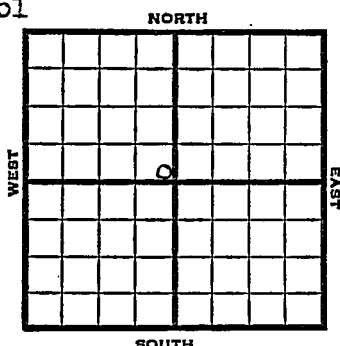


1951

Elev. 2865' REPORT

5/16 Spud 5-13-51
8" @ 624'

7/18 Spud 5-13-51
Gas Well TD 2750
8" @ 624' 5" @ 2749
TD 2750
Her. 2596 Krider 2626
Win. 2698 Co to 2725
100/2694-2714 120/2660-84
70/2626-40 20,500 A
Comp. 15,800,000 gas

COMPLETED

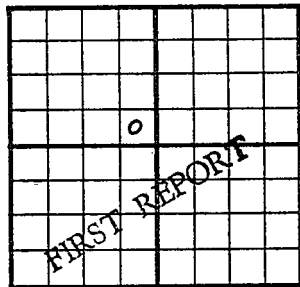County Haskell State KansasSec. 23 (Blk. Twp.) 30 (Sur. Rge.) 32W Map No.Operator Cities ServiceWell No. 1 Farm Cook "D"Elev. Location SE NW100 Ft. From S Line NW100 Ft. From E Line Quarter1st. Report MAY 16 1951

Completion

Remarks

Spudding Date 5-13-51Drlg. Data Hugoton Pool8" @ 624

J. E. TYRA

County Haskell State Kansas

Sec. 23 (Blk. Twp.) 30 (Sur. Rge.) 32W Map No.

Operator Cities Service

Well No. 1 Farm Cook "D"

Elev. 2865 Location SE, NW

700 Ft. From S Line NW

100 Ft. From H. Line Quarter

1st. Report

Completion Jul 18 1951

Remarks	Hugoton Pool
---------	--------------

Spudding Date 5-13-51

Drilg. Data Gas well TD 2750

8" @ 624 5" @ 2749 TD 2750

Her. 2596 Krider 2626 Win. 2698

CO to 2725 100/ 2694-2714 120/ 2660-84

70/ 2626-40 20500 A Comp. 15,800,000 gas

~~J. E. TYRA~~