
DX 78-1

Grant KANSAS

Section 23 Township 30 Range 38W

Well No. 1 Fischer

Company Hugoton Prod.

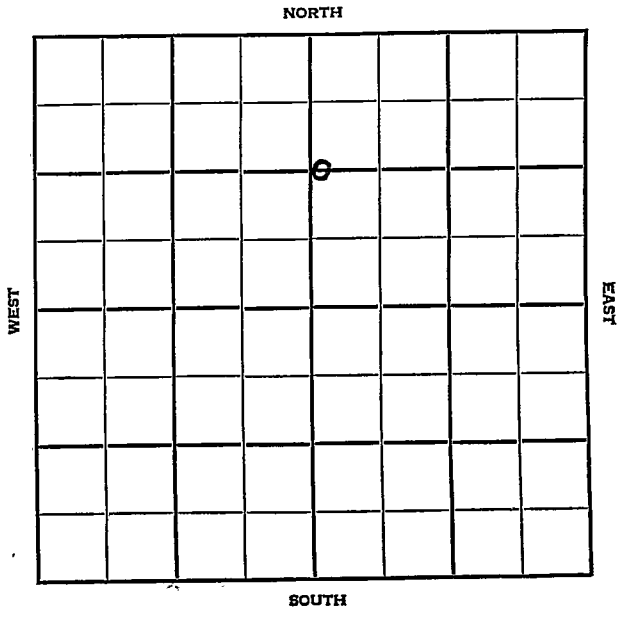

Grant KANSAS

SEC.	TWP.	R.
23	30	38W

WELL NO.

1 Fischer FARM

COMPANY

Hugoton Pord.

CONTRACTOR

Hugoton Pool


1320 Ft. from N. Line

Ft. from S. Line

2578 Ft. from E. Line

Ft. from W. Line

C W/2 W/2 NE

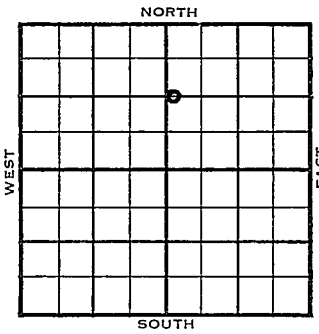

1954	ELEVATION 3142' REPORT
9/8	Location
11/3	Spud 9-9-54 - Gas Well TD 2665' 10-3/4" @ 576' Hol. 2393'; Her. 2425', Kri 2450', Win. 2518', Ft. Riley 2574' TD 2665' 7" @ 2426' 5" @ 2655' Comp. 37,940,000 cfgpd 380# **COMPLETED**

DX-78

FORM 275 FOR SALE BY KANSAS BLUE PRINT CO.


County Grant State Kansas

Sec. 23 (Blk. Twp.) 30 (Sur. Rge.) 38W Map No.

Operator Hugoton Prod.

Well No. 1 Farm Fischer

Elev. Location C W½ W½ NE

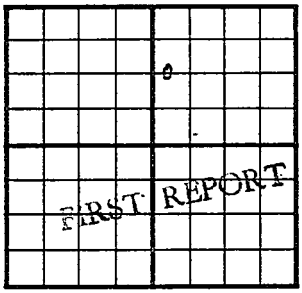

1320 Ft. From N Line NE

2578 Ft. From E Line Quarter

1st. Report SEP 8 1954

Completion

Remarks

Spudding Date

Drlg. Data Hugoton Pool

Location

FABEN GILSTRAP

FORM 275 FOR SALE BY KANSAS BLUE PRINT CO.


County Grant State Kansas

Sec. 23 (Blk. Twp.) 30 (Sur. Rge.) 38W Map No.

Operator Hugoton Prod.

Well No. 1 Farm Fischer

Elev. 3142 Location C W½ W½ NE

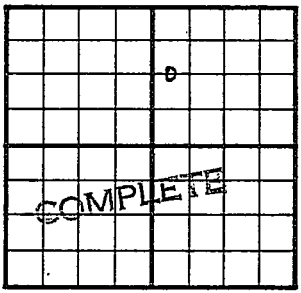

1320 Ft. From N Line NE

2578 Ft. From E Line Quarter

1st. Report

Completion NOV 3 1954

Remarks Hugoton Pool

Spudding Date 9-9-54

Drlg. Data Gas well TD 2665

10 3/4" @ 576 Hol. 2393 Her. 2425

Kri. 2450 Win. 2518 Ft. Riley 2574

TD 2665 7" @ 2426 5" @ 2655

Comp. 37,940,000 cfgpd 380#

FABEN GILSTRAP