

Kingman

KANSAS

Section 23 Township 30 Range 8 WWell No. # 1 A. MarkCompany Magnolia Pet.

NORTH

		0					

WEST

EAST

SOUTH

Kingman

KANSAS



Sec. 23 Twp. 30 R. 8 W

Well No. # 1 A. Mark Farm

Magnolia Pet. Company

Contractor

Spivey Pool


Ft. from N. Line

330 Ft. from S. Line

990 Ft. from E. Line

Ft. from W. Line

SW SE NW

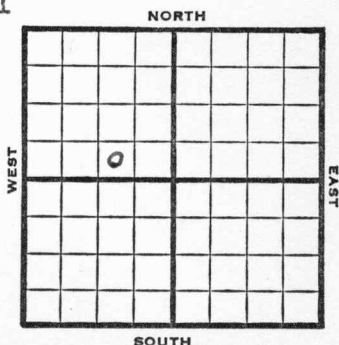

1953

Elev. -

REPORT

5/13

Location

5/21

"

5/28

"

6/3

Abd. Location

ABANDONED

County Kingman State KansasSec. 23 (Blk.) 30 (Sur.) 8W Map No.Operator Magnolia Pet.Well No. 1 Farm A. MarkElev. _____ Location SW SE NW

0

FIRST REPORT

330 Ft. From S Line NW990 Ft. From E Line Quarter1st. Report MAY 13 1953


Completion _____

Remarks _____

Spudding Date _____

Drlg. Data Spivey PoolLocation

County Kingman State Kansas
 Sec. 23 (Blk. 30 (Sur. 8W Map No.
 (Twp. (Rge.)
 Operator Magnolia Pet.
 Well No. 1 Farm A. Mark
 Elev. Location SW SE NW

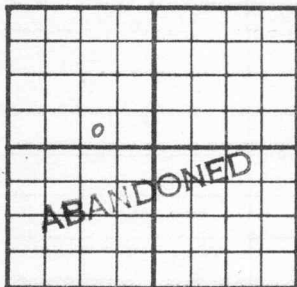

330 Ft. From S Line NW
990 Ft. From E Line Quarter

1st. Report

Completion JUN 3 1953

Remarks Spivey Pool

Spudding Date

Drlg. Data

Abd. location