

KANSAS


FORM 51 5M 6-46 PETROL

Barber county

Section 24 Township 30 Range 13-W

Well No. #1, Smith-Stump

Company Cities Service Oil Company

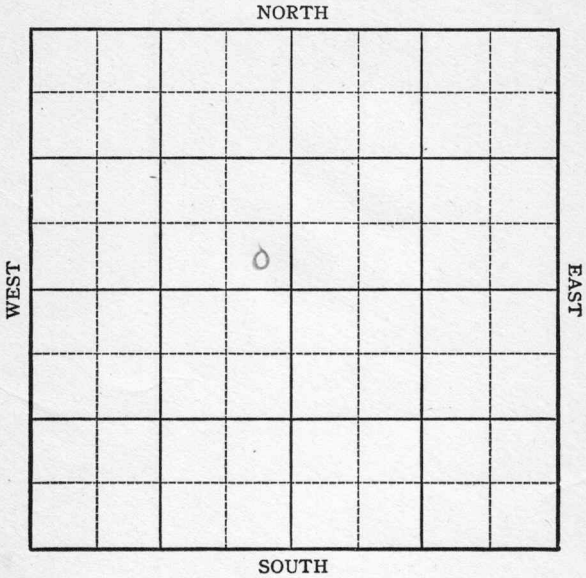

Sec. 24 Twp. 30 R. 13W

Well No. 1 Smith-Stump Farm

Cities Service Company


Marjorie Pool

Ft. from N. Line

330 Ft. from S. Line

330 Ft. from E. Line

Ft. from W. Line

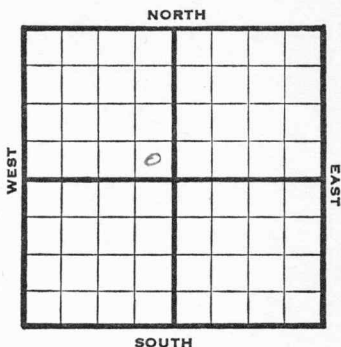

SE NW

REPORT

1946 Elev. 1747'

11/20 Location

11/27 RUR

12/3 10" @ 318'
Drlg 1160'

12/10 Drlg 3225'

12/17 Topeka 2910'
Lans 3796'
Drlg 4054'

1947

1/2 Miss 4231'
Viola 4426'
Simp Sd 4542'
Arb 4644
TD 4674'

ABANDONED

Map No. 92 Sec. 24 Twp. 30 R. 13W

Well No. 1 Smith-Stump

Cities Service Company

FIRST REPORT Contractor

SE NW

SECTION PLAT

_____ Ft. from N. Line

330 Ft. from S. Line

330 Ft. from E. Line

_____ Ft. from W. Line

Barber County

Location X

Rig up _____

Drilling and Remarks:

RECORD

Cased _____ in., _____ ft.

Sand _____

Gas _____

Oil _____

Total Depth _____

PRODUCTION

1st 24 hrs. Nat. _____

1st 24 hrs. after shot _____

Gas _____ Cu. Ft.

Dry Hole _____

Abandoned _____

Date

NOV 20 1946

19

S. J. LEWIS

Scout

Map No. 92 Sec. 24 Twp. 30 R. 13W

Well No. 1 Smith-Stump

Cities Service Company

ABANDONED Contractor

SE NW

E1, 1742
SECTION PLAT

 Ft. from N. Line

330 Ft. from S. Line

330 Ft. from E. Line

 Ft. from W. Line

Barber County

RECORD

Location

Cased in., ft.

Rig up

Sand

Drilling and Remarks:

Gas

Oil

Total Depth 4674

*Miss 4281
 Viat 426
 Simp Sol 4542
 Cr 4644*

PRODUCTION

1st 24 hrs. Nat.

1st 24 hrs. after shot

Gas Cu. Ft.

Dry Hole

Abandoned

Date

JAN 2 1947 19

S. J. LEWIS Scout