
Form 51-5M-12-36 Com'l Grant KANSAS

Section 24 Township 30 Range 35-W

Well Number 1 Rogers

Company. United Production

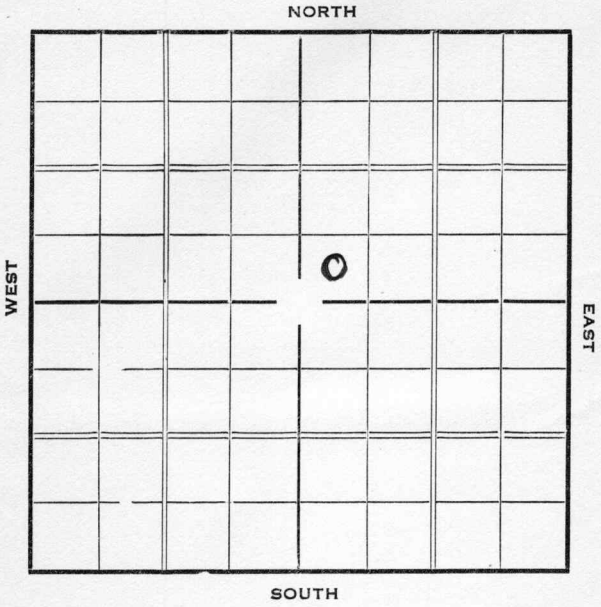


Form 252-A—5M—2-37—Palace KANSAS Grant

Sec. 24 Twp. 30 R. 35-W

Well No. #1 Rogers Farm

United Production Company

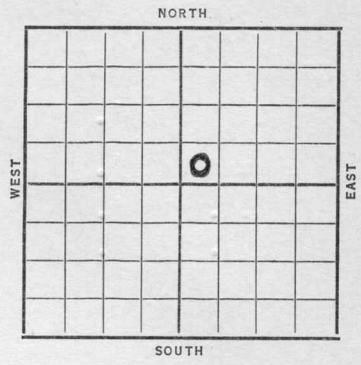

_____ Ft. from N. Line

330 Ft. from S. Line

_____ Ft. from E. Line

330 Ft. from W. Line

Date	REPORT
1937	
4/21	Location
4/30	"
5/7	"
5/14	"
5/21	"
5/28	Drlg. 1915'.
6/4	" "
6/11	SD 1915'.
6/19	"
6/25	"
7/2	7" @ 2426'. WOC.
7/9	" " "
7/16	T.D. 2670' SD.
7/23	" " "
7/30	" " "

OVER

1937

8/4 7" @ 2426'.

Sand 2426'.

T.D. 2746'.

P.B. 2600'.

6 M gas.

COMPLETED

Form 26—1M Bks.—2-29 KANSAS Grant


Map No. NM Sec. 24 Twp. 30 R. 35W

Well No. 1 Rogers.

United Production Company

Contractor

SECTION PLAT

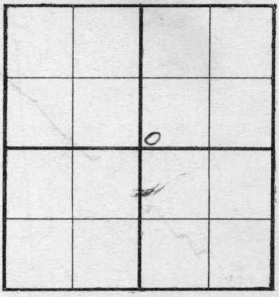

_____ Ft. from N. Line

330 Ft. from S. Line

_____ Ft. from E. Line

330 Ft. from W. Line

FIRST REPORT

Location V

Rig up

Drilling and Remarks:

RECORD

Cased _____ in., _____ ft.

Sand

Gas

Oil

Total Depth

PRODUCTION

1st 24 hrs. Nat.

1st 24 hrs. after shot

Gas _____ Cu. Ft.


Dry Hole

Abandoned

Date

APR 21 1937 19

S. J. LEWIS Scout

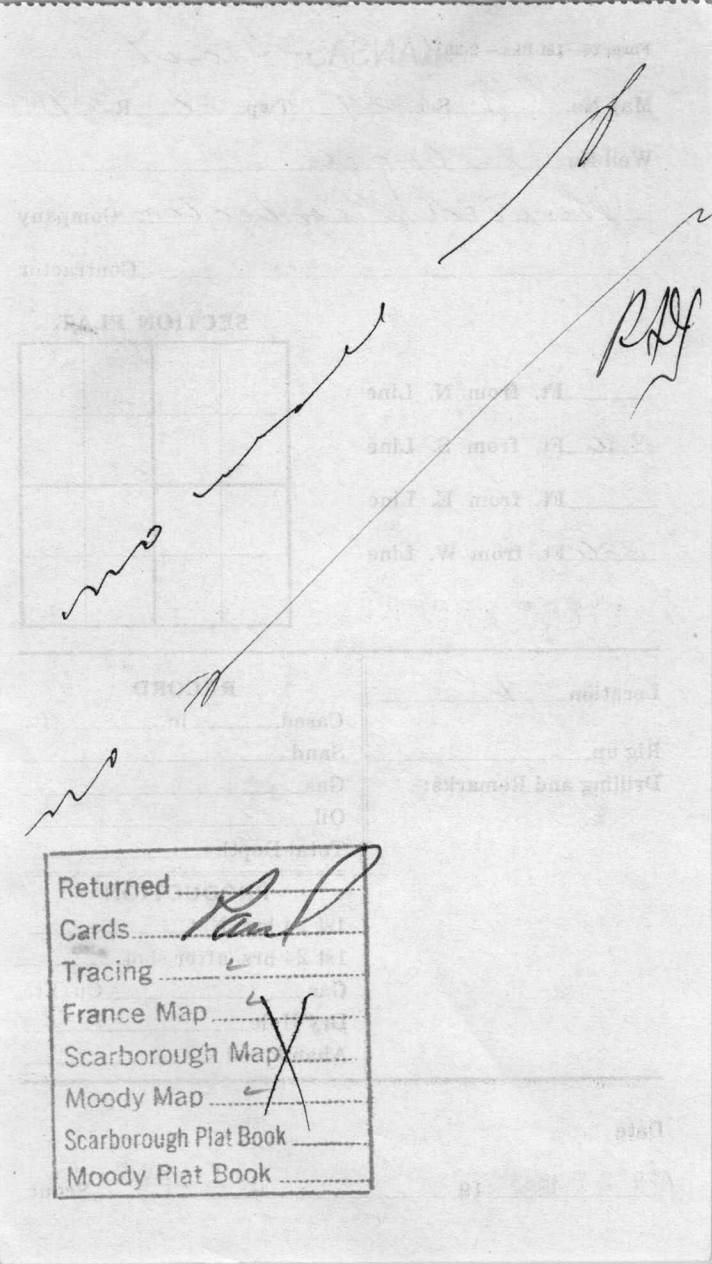
Returned
Cards
Tracing
France Map
Scarborough Map
Moody Map
Scarborough Plat Book
Moody Plat Book

Form 26—1M Bks.—2-29 Grant KANSAS

Map No. _____ Sec. 24 Twp. 30 R. 35 W


Well No. 1 - Rogers

United Prod Company

Contractor

COMPLETED

SECTION PLAT

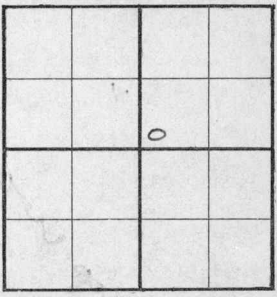

_____ Ft. from N. Line

330 Ft. from S. Line

_____ Ft. from E. Line

330 Ft. from W. Line

Location _____

Rig up _____

Drilling and Remarks:

P.B. 2600

6 M. gas

RECORD

Cased 7 in., 2426 ft.

Sand 2426

Gas _____

Oil _____

Total Depth 2746

PRODUCTION

1st 24 hrs. Nat. _____

1st 24 hrs. after shot _____

Gas _____ Cu. Ft.


Dry Hole _____

Abandoned _____

Date

AUG 4 - 1937 19

H. D. Hatfield Scout

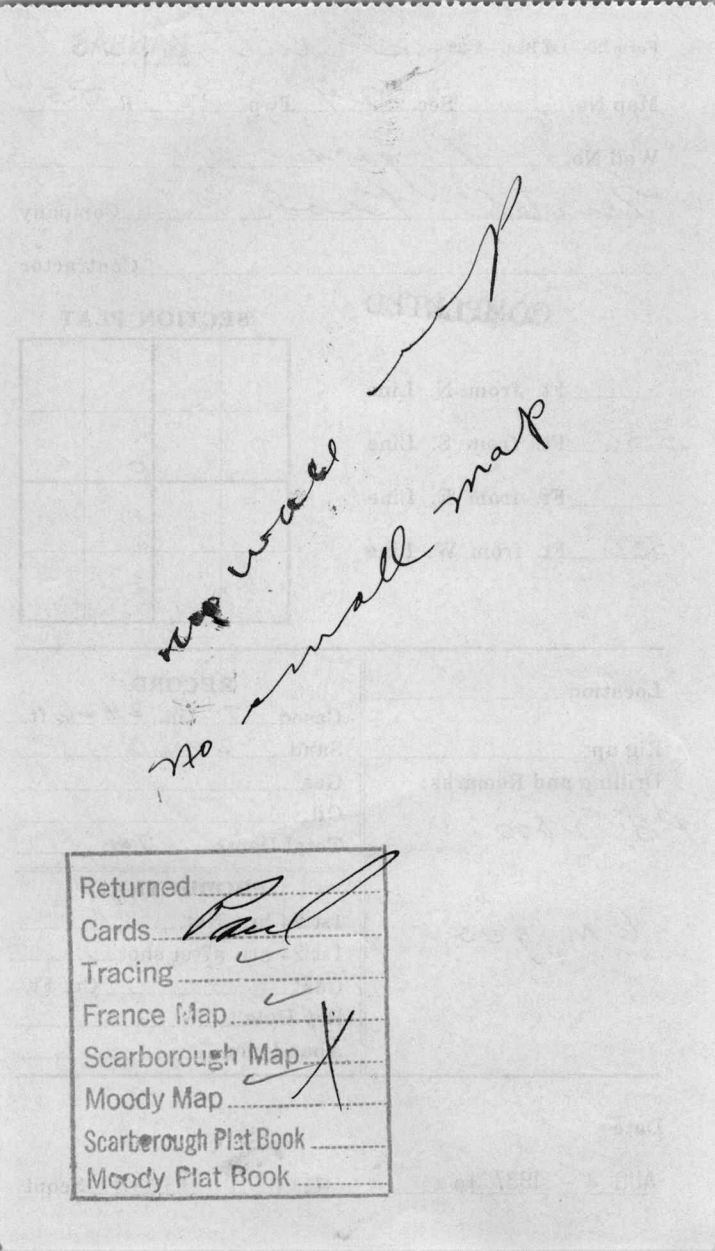
Returned
Cards
Tracing
France Map
Scarborough Map
Moody Map
Scarborough Plat Book
Moody Plat Book