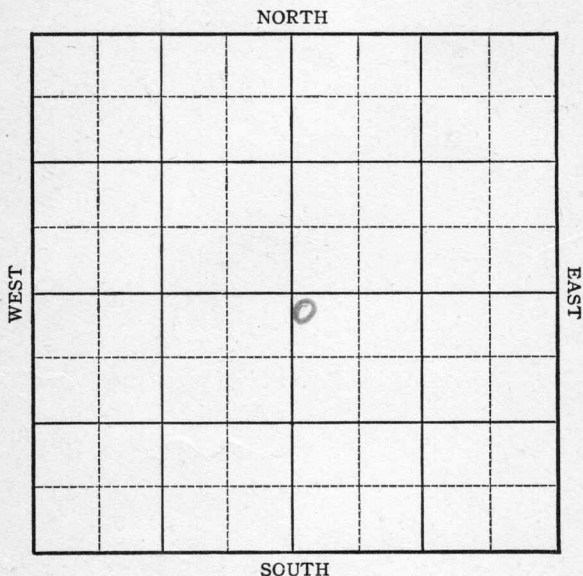


Section 24 Township 30 Range 36WWell No. #1, BrewerCompany United Prod.

KANSAS

Grant County

Sec. 24 Twp. 30 R. 36W

Well No. #1 Brewer Farm _____
United Prod. _____ Company

Hugoton


100 Ft. from N. Line

_____ Ft. from S. Line

_____ Ft. from E. Line

100 Ft. from W. Line

NW SE

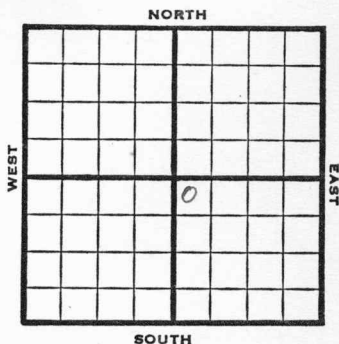

1946

Elev. 3001

REPORT

3/20 10" @ 717
720'

3/28 Drlg. 2571'

4/4 TD 2745
7" @ 2740 RUST

4/10 " " "

4/16 " " "

4/23 " " "

5/1 209 shots 2520-2724
21000 acid

5/7 " " "

5/14 " " "

5/21 " " "

5/29 " B " "

6/5 7" @ 2740

TD 2745

Perf.

21,000 acid.

9,240,000 Gas.

415# R Pr.

COMPLETED

KANSAS

Kansas Pool Name HugotonMap No. None Sec. 24 Twp. 30 R. 36WWell No. 1 BrewerUnited Prod.

Company

FIRST REPORT

Contractor

NW SE

SECTION PLAT

		0	

100 Ft. from N. Line Ft. from S. Line Ft. from E. Line100 Ft. from W. LineGrant CountyLocation Rig up

Drilling and Remarks:

10"-717
720'

RECORD

Cased in., ft.Sand Gas Oil Total Depth

PRODUCTION

1st 24 hrs. Nat. 1st 24 hrs. after shot Gas Cu. Ft.Dry Hole Abandoned

Date

MAR 20 1946 19

S. J. LEWIS

Scout

KANSAS

Kansas Pool Name HugotonMap No. 24 Sec. 24 Twp. 30 R. 36WWell No. 1 BrewerUnited Prod. Company

COMPLETED

Contractor

NW SE

E 1300/
SECTION PLAT100 Ft. from N. Line

Ft. from S. Line

Ft. from E. Line

100 Ft. from W. Line

		0	

Grant County

Location

Rig up

Drilling and Remarks:

7" @ 2740

Prof.

21000 acid

9,240,000 Gas

4/15 R/P

RECORD

Cased _____ in., _____ ft.

Sand _____

Gas _____

Oil _____

Total Depth 2745

PRODUCTION

1st 24 hrs. Nat. _____

1st 24 hrs. after shot _____

Gas _____ Cu. Ft.

Dry Hole _____

Abandoned _____

Date

JUN 5 1946 19

S. J. LEWIS Scout