


Kingman KANSAS

DX 78-1

Section 24 Township 30 Range 8W

Well No. 1 Joe Tjaden "A"

Company Stanolind

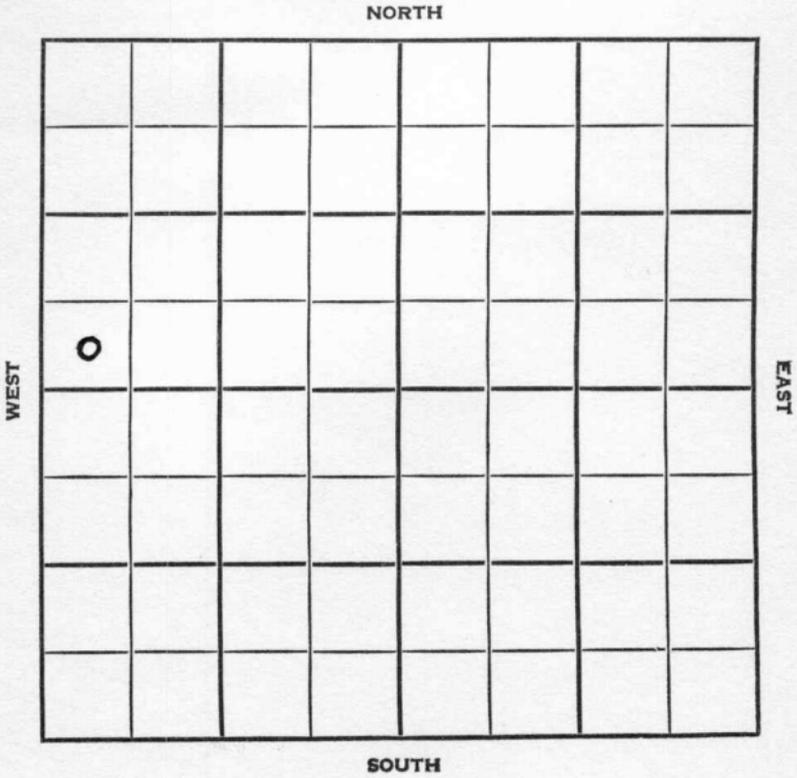

Kingman KANSAS

SEC.	TWP.	R.
24	30	8W

WELL NO. **1 Joe Tjaden "A"** FARM

COMPANY **Stanolind**


CONTRACTOR **Noble Drlg.**

Spivey Pool
Ft. from N. Line

330 Ft. from S. Line

Ft. from E. Line

330 Ft. from W. Line

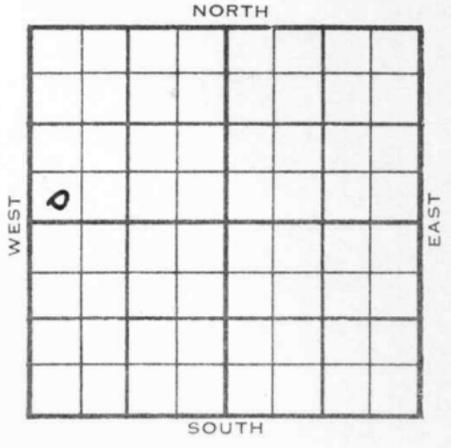

SW SW NW

	ELEVATION	REPORT
1954	1544'	

6/15	spdg 6-7-54 8" @ 203 Drlg. 2434
6/23	Miss 4238 DST 4234-69, 1 hr, 200' O & GCM 240' MCO 120' GCO 10" wtr. 1540# DST 4269-99, 1 hr, 185' O & GCM, 85' wtr. 1348# DST 4298-4360 1 hr, 45' M 1452# RTD 4360 5" @ 4359
7/28	Spud 6-7-54 Oil Well TD 4360' 8" @ 203' Miss 4238' DST 4234-69', opn 1 hr., rec. 200' O&GCM, 240' MCO, 120' GCO, 10' wtr. 1540# DST 4269-99', opn 1 hr., rec. 185' O&GCM, 85' wtr, 1348# DST 4298-4360', opn 1 hr., rec. 45' mud, 1452# TD 4360' 5" @ 4359', CO to 4315'

OVER

(Information Brought Forward)

1954
7/28

40/4272-82, 32 gw 2 goph 3 hrs.
sd-oil-frac, S/22 bfph 95% wtr.

CO to 4315

20/4272-77, 40 gwph 2 go

frac

S/1 $\frac{1}{4}$ bfph 98% wtr.

frac.

PB 4265

32/4246-54, S/10 boph

sd-oil-frac

F/50 boph

Comp. F 748 bopd

COMPLETED

County Kingman State Kansas

Sec. 24 (Blk. 30) (Sur. 8W) (Twp.) (Rge.) Map No.

Operator Stanolind

Well No. 1 Farm Joe Tjaden "A"

Elev. Location SW SW NW



330 Ft. From S Line NW

330 Ft. From W Line Quarter

Ist. Report JUN 15 1954

Completion

Remarks

Noble Drlg. - Contr.

Spudding Date 6-7-54


Drlg. Data Spivey Pool

8" @ 203 drlg. 2434

JUN 18 1954

Scout Cards	<i>DM</i>
Land Small Map	
Land Wall Map	<i>3</i>
Tracings	
France Map	
Pierce Map	
Misc.	

Orig. Data

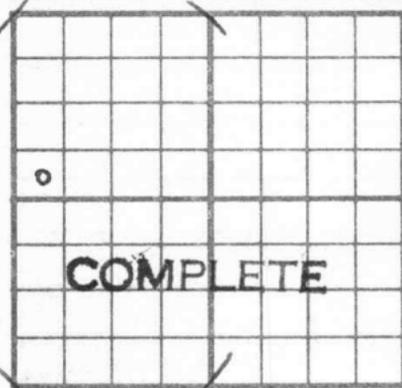County Kingman State KansasSec. 24 (Blk.
Twp.) 30 (Sur.
Rge.) 8W Map No.Operator StanolindWell No. 1 Farm Joe Tjaden "A"Elev. 1544 Location SW SW NW330 Ft. From S Line NW330 Ft. From W Line Quarter

Ist. Report

Completion JUL 28 1954Remarks Spivey PoolNoble Drlg. - Contr.Spudding Date 6-7-54Drlg. Data Oil well TD 43608" @ 203 Miss. 4238 DST 4234-69open 1 hr. Rec. 200' o & gcm 240' mco120' gco 10' wtr. 1540# DST 4269-99open 1 hr. Rec. 185' o & gcm 85' wtr.1348# DST 4298-4360 open 1 hr. Rec.45' mud 1452# TD 4360 5" @ 4359CO to 4315 40/ 4272-82 32 gw 2 goph3 hr. sd-oil-frac S/ 22 bfph 95% wtr.CO to 4315 20/ 4272-77 40 gwph 2 gofrac S/ 1 $\frac{1}{4}$ bfph 98% wtr. fracPB 4265 32/ 4246-54 S/ 10 bophsd-oil-frac F/ 50 bophComp. F/ 748 bopd

J. G. McGEHEE

AUG 4 1954

Scout Cards	<i>10</i>
Land Small Map	
Land Wall Map	
Tracings	<i>33</i>
France Map	
Place Map	
Misc.	