


Section 24 Township 30 Range 1W

Well No. 1 Parker

Company Sherrrod & Apperson

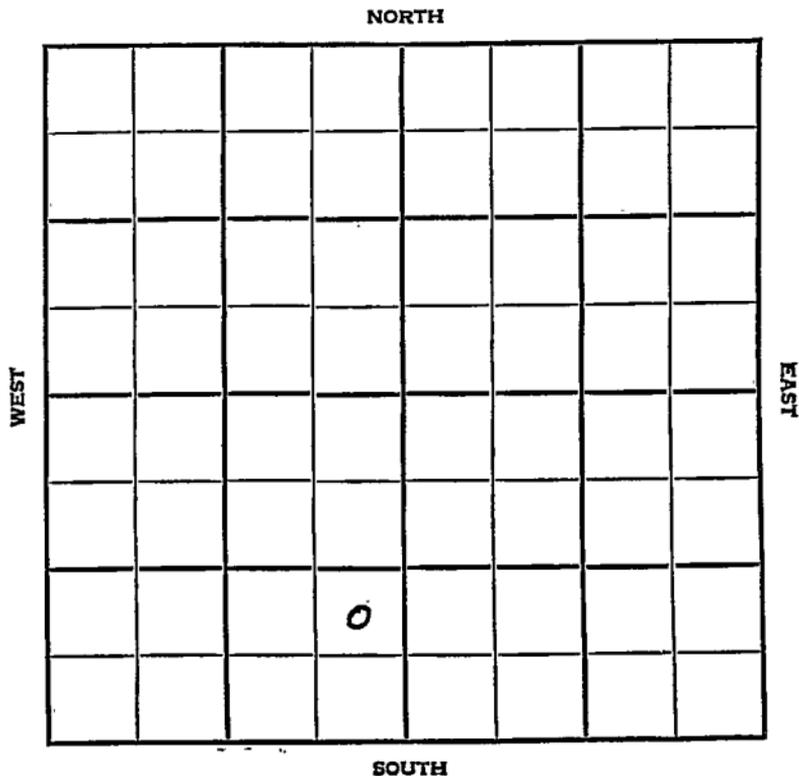

Sumner KANSAS

SEC.	TWP.	R.
24	30	1W ✓

WELL NO.

1 Parker

FARM

COMPANY

Sherrod & Apperson

CONTRACTOR

Barnett


Wildcat

_____ Ft. from N. Line

990 _____ Ft. from S. Line

330 _____ Ft. from E. Line

_____ Ft. from W. Line

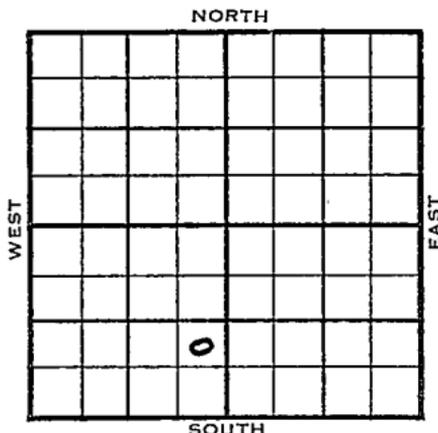

NE SE SW

Mid-States FO

	ELEVATION	REPORT
1954	1230	
6/15	RUR	
6/23	8" @ 287	Stal. 2525 KC 2852 B KC 3132'
6/30	Miss 3473	Kh 3832 Simp sd 3880 DST 3874-98 1 hr. 960' wtr 840#
12/7	Spudding	6-11 -54 D&A TD 3985 8" @ 287 Stal 2525 KC 2852 BKC 3132 Miss. 3473 Kh. 3832 Simp. 3880 DST 3874-98 open 1 hr. Rec. 960' wtr. 840# Arb 3969 TD 3985 D&A

ABANDONED


County Sumner State Kansas

Sec. 24 (Blk. Twp.) 30 (Sur. Rge.) 1W Map No.

Operator Sherrod & Apperson

Well No. 1 Farm Parker

Elev. _____ Location NE SE SW

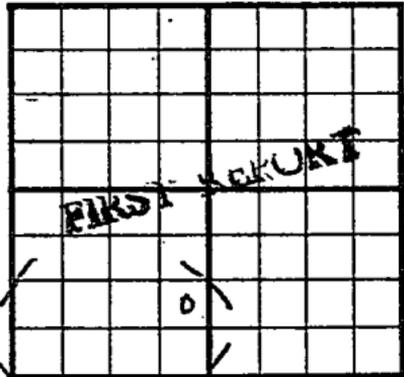

990 Ft. From S Line SW

330 Ft. From E Line Quarter

Ist. Report JUN 15 1954

Completion _____

Remarks Mid-States farmout

Barnett - Contr.

Spudding Date _____

Drilg. Data Wildcat

RUR

Kansas


County Summer State

Sec. 24 (Blk. Twp.) 30 (Sur. Rge.) 1W Map No.

Operator Sherrod & Apperson

Well No. 1 Farm Parker

Elev. 1230 Location NE SE SW

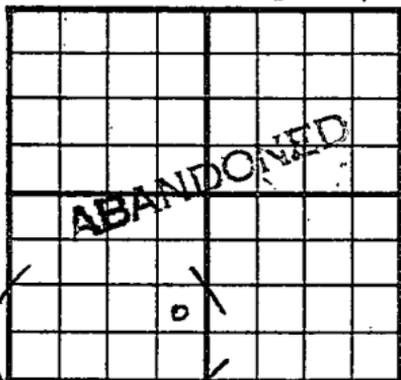

990 Ft. From S Line SW

330 Ft. From E Line Quarter

Ist. Report

Completion JUL 7 1954

Remarks Wildcat

Barnett - Contr.

Spudding Date 6-11-54

Drilg. Data D & A TD 3985

8" @ 287 Stal. 2525 KC 2852

B KC 3132 Miss. 3473 Kh. 3832

Simp. 3880 DST 3874-98 open 1 hr.

Rec.. 960' wtr. 840# Arb. 3969

TD 3985

D & A

J. G. McGEHEE