

PT

State Geological Survey 1-30-25W

AFFIDAVIT OF COMPLETION FORM

WICHITA, BRANCH

ACO-1

and

This form shall be filed in triplicate with the Kansas Corporation Commission, 200 Colorado Derby Building, Wichita, Kansas 67202, within ten days after the completion of the well, regardless of how the well was completed. Circle one: Oil, gas, (dry), SWD, OWWO, injection. Type and complete ALL sections. Applications must be filed for dual completion, commingling, salt water disposal and injection. Attach wireline logs (i.e. electrical log, sonic log, gamma ray neutron log, etc.) KCC#-(316)263-3238.

OPERATOR Coastal Oil & Gas Corporation

API NO. 15-025-20,571

ADDRESS P.O. BOX 1332, Amarillo, TX 79189

COUNTY Clark

FIELD Minnigola

\*\*CONTACT PERSON Bobby Smith

PROD. FORMATION NONE

PHONE(806) 372-4391

LEASE McGee

PURCHASER NONE

WELL NO. 1

ADDRESS

WELL LOCATION C-NW-NE-SE

DRILLING Raines & Williamson Oil Co., Inc.

990 Ft. from East Line and

CONTRACTOR


2310 Ft. from South Line of

ADDRESS 435 Page Court, 220 West Douglas

the SEC. 1 TWP. 30S RGE. 25W

Wichita, Ks 67202

PLUGGING Dowell Well

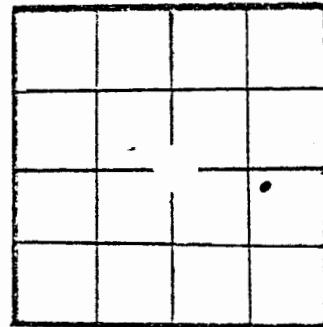

WELL PLAT

CONTRACTOR

ADDRESS Ulysses, KS.

KCC

KGS

MISC

(Office Use)

TOTAL DEPTH 5372' PBD

SPUD DATE 2-13-82 DATE COMPLETED 2-28-82

ELEV: GR 2561 DF KB

DRILLED WITH (CABLE) (ROTARY) (NEW) TOOLS (New) / (NEW) casing.

CASING RECORD

Report of all strings set — surface, intermediate, production, etc.

Purpose of string	Size hole drilled	Size casing set (in O.D.)	Weight lbs/ft.	Setting depth	Type cement	Sacks	Type and percent additives
Surface	12 1/2	8 5/8"	24#	620	POZ	175	2% CaCl2 10# Gilsonite
					Class H	150	3% CaCl2

LINER RECORD

PERFORATION RECORD

Top, ft.	Bottom, ft.	Sacks cement	Shots per ft.	Size & type	Depth interval

TUBING RECORD

Size	Setting depth	Pecker set at

RECEIVED

FRACTURE, SHOT, CEMENT SQUEEZE RECORD

W22-08

Name of lowest fresh water producing stratum Ogallah Depth 550

Estimated height of cement behind Surface Pipe Surface

DV USED? NO

1-30-25w

WELL LOG

Formation Description, Contents, etc.	Top	Bottom	Name	Depth
Cedar Hills	1050			
Stone Corral	1500			
Krider	2800			
Root Shale	3650			
Topeka	3906			
Heebner	4372			
Lansing	4490			
Kansas City	4598			
Marmaton	5022			
Cherokee	5154			
Atoka	5290			
Mississippian	5356			
TD	5372			

A F F I D A V I T

STATE OF TEXAS, COUNTY OF POTTER SS, \_\_\_\_\_

BOBBY SMITH OF LAWFUL AGE, BEING FIRST DULY SWORN UPON HIS OATH,

DEPOSES THAT HE IS Drilling Engineer (FOR) ~~(OF)~~ Coastal Oil & Gas Corporation

OPERATOR OF THE McGee LEASE, AND IS DULY AUTHORIZED TO MAKE

THIS AFFIDAVIT FOR AND ON THE BEHALF OF SAID OPERATOR, THAT WELL NO. 1 ON