

Handwritten initials

STATE CORPORATION COMMISSION - KANSAS
OIL & GAS CONSERVATION DIVISION

WELL COMPLETION OR RECOMPLETION FORM
ACO-1 WELL HISTORY

DESCRIPTION OF WELL AND LEASE

Operator: License # 6033
Name Murfin Drilling Company
Address 250 N. Water, Suite 300
City/State/Zip Wichita, Ks. 67202

Operator Contact Person Glenda Newell
Phone 316-267-3241

Contractor: License # 6033
Name Murfin Drilling Company

Wellsite Geologist Mac Armstrong
Phone 316-722-5141

PURCHASER.....

Designate Type of Completion
 New Well Re-Entry Workover
 Oil SWD Temp Abd
 Gas Inj Delayed Comp.
 Dry Other (Core, Water Supply etc.)

If **OWNO**: old well info as follows:
Operator
Well Name
Comp. Date Old Total Depth.....

WELL HISTORY

Drilling Method:
 Mud Rotary Air Rotary Cable
..7-2-85... ..7-12-85... ..7-13-85...
Spud Date Date Reached TD Completion Date
5380' RTD
Total Depth PBD

Amount of Surface Pipe Set and Cemented at.....feet

Multiple Stage Cementing Collar Used? Yes No
If yes, show depth set.....feet

If alternate 2 completion, cement circulated
from.....feet depth to.....w/.....SX cmt

API NO. 15-..... 025-20,917.....

County..... Clark.....

..S/2..SW...NW... Sec.2... Twp.30S...Rge.25... East West


.....2970' Ft North from Southeast Corner of Section
.....4620' Ft West from Southeast Corner of Section
(Note: Locate well in section plat below)

Lease Name..... Rooney..... Well #..... B.1-2

Field Name..... Pool Ext.....

Producing Formation..... Morrow.....

Elevation: Ground.. 2572' GL.....KB. 2581 KB.....
Section Plat

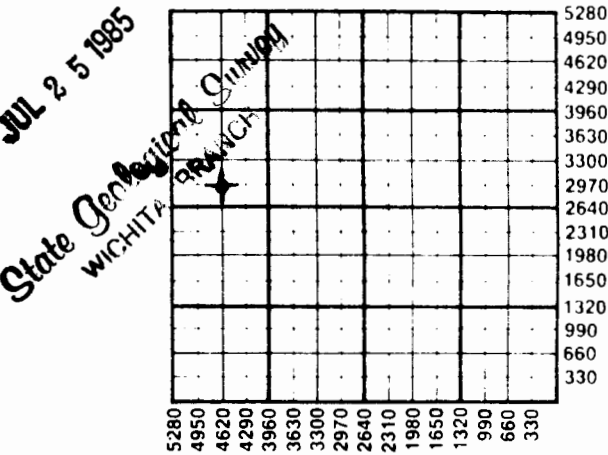

WATER SUPPLY INFORMATION
Source of Water:
Division of Water Resources Permit #

Groundwater.....Ft North from Southeast Corner
(Well)Ft West from Southeast Corner of
Sec Twp Rge East West

Surface Water.....Ft North from Southeast Corner
(Stream, pond etc).....Ft West from Southeast Corner
Sec Twp Rge East West

Other (explain)
(purchased from city, R.W.D.#)

Disposition of Produced Water: Disposed Reinjecting
STATE CORPORATION COMMISSION
Wichita, Kansas

Docket #

RECEIVED
JUL 2 1985

INSTRUCTIONS: This form shall be completed in duplicate and filed with the Kansas Corporation Commission, 200 Colorado Derby Building, Wichita, Kansas 67202, within 90 days after completion or recompletion of any well. Rule 82-3-130 and 82-3-107 apply. Information on side two of this form will be held confidential for a period of 12 months if requested in writing and submitted with the form. See rule 82-3-107 for confidentiality in excess of 12 months. One copy of all wireline logs and drillers time log shall be attached with this form. Submit CP-4 form with all plugged wells. Submit CP-111 form with all temporarily abandoned wells.