

STATE CORPORATION COMMISSION OF KANSAS
OIL & GAS CONSERVATION DIVISION
WELL COMPLETION OR RECOMPLETION FORM
ACO-1 WELL HISTORY
DESCRIPTION OF WELL AND LEASE

S

API NO. 15-025-21,011
County Clark
SW SE NW Sec 9 Twp 30 Rge 25 East
West

Operator: License # 09408
Name Trans Pacific Oil Corporation
Address 410 One Main Place
City/State/Zip Wichita, Ks. 67202

2970 Ft North from Southeast Corner of Section
3630 Ft West from Southeast Corner of Section
(Note: Locate well in section plat below)

Purchaser NA

Lease Name Alley Well # 1

Operator Contact Person Alan D. Banta
Phone 316-262-3596

Field Name Norcan


Producing Formation NA

Contractor: License # 05841
Name Trans. Pac. Drilling, Inc.

Elevation: Ground 2564 KB 2573

Wellsite Geologist Ernie Morrison
Phone 316-788-1150

Section Plat

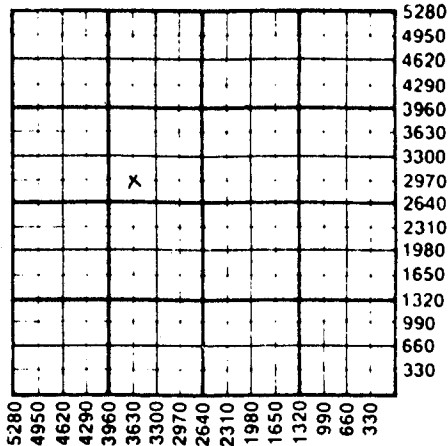

Designate Type of Completion
New Well Re-Entry Workover
Oil SWD Temp Abd
Gas Inj Delayed Comp.
X Dry Other (Core, Water Supply etc.)

If OWWO: old well info as follows:
Operator
Well Name
Comp. Date Old Total Depth

WELL HISTORY

Drilling Method:
X Mud Rotary Air Rotary Cable
5/24/88 6/4/88 6/4/88
Spud Date Date Reached TD Completion Date
5350
Total Depth PBTD

Amount of Surface Pipe Set and Cemented at 653 feet
Multiple Stage Cementing Collar Used? Yes X No
If yes, show depth set feet
If alternate 2 completion, cement circulated from feet depth to w/ SX cmt
Cement Company Name
Invoice #

WATER SUPPLY INFORMATION
Disposition of Produced Water: Disposal
Docket # Repressuring

Questions on this portion of the ACO-1 call:
Water Resources Board (913) 296-3717

Source of Water:
Division of Water Resources Permit # T88-270

Groundwater Ft North from Southeast Corner (Well) Ft West from Southeast Corner of Sec Twp Rge East West

Surface Water Ft North from Southeast Corner (Stream, pond etc) Ft West from Southeast Corner Sec Twp Rge East West

explain) (purchased from city, R.W.D. #)

INSTRUCTIONS: This form shall be completed in triplicate and filed with the Kansas Corporation Commission, 200 Colorado Derby Building, Wichita, Kansas 67202, within 120 days of the spud date of any well. Rule 82-3-130, 82-3-107 and 82-3-106 apply. Information on side two of this form will be held confidential for a period of 12 months if requested in writing and submitted with the form. See rule 82-3-107 for confidentiality in excess of 12 months. One copy of all wireline logs and drillers time log shall be attached with this form. Submit CP-4 form with all plugged wells. Submit CP-111 form with all temporarily abandoned wells.

All requirements of the statutes, rules and regulations promulgated to regulate the oil and gas industry have been fully complied with and the statements herein are complete and correct to the best of my knowledge.

Signature Alan D. Banta
Title Exploration Manager Date 6/29/88

Subscribed and sworn to before me this 29th day of June 1988
Notary Public Sondra J. Follis
Date Commission Expires May 13, 1991

K.C.C. OFFICE USE ONLY
Letter of Confidentiality Attached
Wireline Log Received
Drillers Timelog Received
Distribution
KCC SWD/Rep NGPA
KGS Plug Other (Specify)

KANSAS GEOLOGICAL SURVEY
WICHITA BRANCH

JUL 08 1988

SONDRA J. FOLLIS
NOTARY PUBLIC
STATE OF KANSAS
My Appt. Exp. 5-13-91

Sec. 9, Twp. 30 Rge. 25 W