


P

STATE OF KANSAS
STATE CORPORATION COMMISSION

WELL PLUGGING RECORD

Give All Information Completely
Make Required Affidavit
Mail or Deliver Report to
Conservation Division
State Corporation Comm.
245 North Water
Wichita, KS 67202

Clark County. Sec. 19 Twp. 30S Rge. 25 ~~EE~~W
Location as "NE/CNW $\frac{1}{2}$ SW $\frac{1}{2}$ " or footage from lines _____
E/2 NW NW
Lease Owner Pendleton Land & Exploration, Inc.
Lease Name Widmer Well No. #1
Office Address 23 Inverness Way East, Englewood, CO 80112
Character of Well (Completed as Oil, Gas or Dry Hole) _____

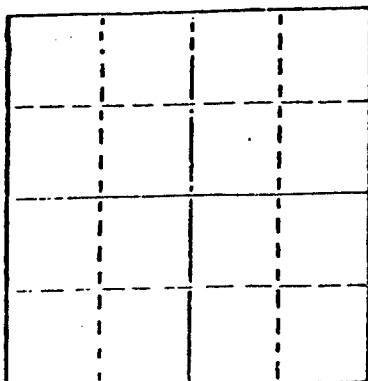

Locate well correctly on above Section Plat

Dry Hole
Date Well completed 2-25-83 19
Application for plugging filed 2-25-83 19
Application for plugging approved 2-25-83 19
Plugging commenced 2-25-83 19
Plugging completed 2-25-83 19
Reason for abandonment of well or producing formation _____
Commercial quantities of oil not found
If a producing well is abandoned, date of last production _____ 19.

Was permission obtained from the Conservation Division or its agents before plugging was commenced? Yes

Name of Conservation Agent who supervised plugging of this well Bob Tarbutton
Producing formation _____ Depth to top _____ Bottom _____ Total Depth of Well 5500'
Show depth and thickness of all water, oil and gas formations.

OIL, GAS OR WATER RECORDS

CASING RECORD

FORMATION	CONTENT	FROM	TO	SIZE	PUT IN	PULLED OUT
				8 5/8"	1519'	None

Describe in detail the manner in which the well was plugged, indicating where the mud fluid was placed and the method or methods used in introducing it into the hold. If cement or other plugs were used, state the character of same and depth placed, from _____ feet to _____ feet for each plug set.

Plug @ 1560' w/50 sx.
Plug @ 720' w/40 sx.
Plug @ 40' w/10 sx.
Rat Hole 10 sx.

(If additional description is necessary, use BACK of this sheet)

Name of Plugging Contractor Silverado Drilling, Inc.

STATE OF Kansas COUNTY OF Sedgwick, ss.

Joseph B. Brunhardt, Jr., Acct. of Silverado Drilling (employee of owner) or (owner or operator) of the above-described well, being first duly sworn on oath, says: That I have knowledge of the facts, statements, and matters herein contained and the log of the above-described well as filed and that the same are true and correct. So help me God.

Joseph B. Brunhardt, Jr.

19-30-25W⁰¹

STATE OF KANSAS
STATE CORPORATION COMMISSION
CONSERVATION DIVISION
245 North Water
WICHITA, KANSAS 67202

Rev. 6-3-74
FORM CP-1

WELL PLUGGING APPLICATION FORM
File One Copy

API Number 15 - - (of this well)

Lease Owner Pendleton Land & Exploration, Inc.

Address 23 Inverness Way East, Englewood, CO 80112

Lease (Farm Name) Widmer Well No. #1

Well Location E/2 NW NW Sec. 19 Twp. 30S Rge. 25 (E) (W) X

County Clark Total Depth 5500' Field Name

Oil Well Gas Well Input Well SWD Well Rotary D & A X

Well Log attached with this application as required Yes

Date and hour plugging is desired to begin 4:00 p.m. 2-25-83

PLUGGING OF THIS WELL WILL BE DONE IN ACCORDANCE WITH K.S.A. 55-128 OF THE RULES AND REGULATIONS OF THE STATE CORPORATION COMMISSION.

Name of company representative authorized to be in charge of plugging operations:

Paul Stephens Address Box 166, Pratt, Kansas 67124

Plugging Contractor Silverado Drilling, Inc. License No.

Address 435 Page Court, 220 W. Douglas, Wichita, Kansas 67202

Invoice covering assessment for plugging this well should be sent to:

Name Pendleton Land & Exploration, Inc.

Address 23 Inverness Way East, Englewood, CO 80112

and payment will be guaranteed by applicant or acting agent.

RECEIVED
STATE CORPORATION COMMISSION

MAR 23 1983

CONSERVATION DIVISION
Wichita, Kansas

Signed: Joseph B. Brungardt, Jr.
Applicant or Acting Agent
Joseph B. Brungardt, Jr.
Date: 3-3-83