

Kiowa

KANSAS

SECTION 25 TOWNSHIP 30S RANGE 17W

WELL NO. #1 Robbins I


COMPANY Gulf Oil Corp.

NORTH

C NE

WEST

EAST

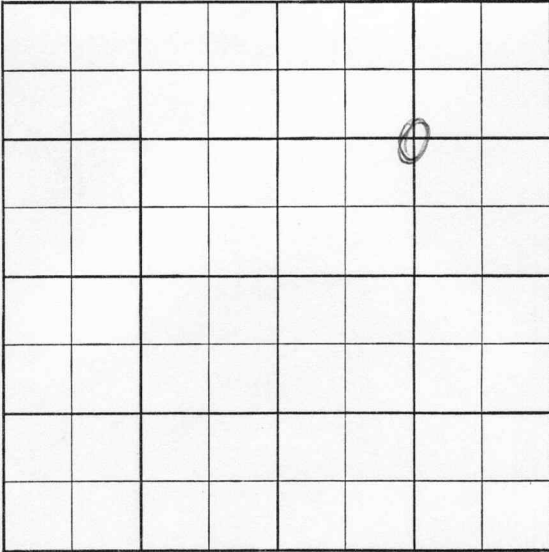

SOUTH

CO. Kiowa ELEV. _____SEC. 25 TWP. 30 RGE. 17WCOMPANY Gulf Oil Corp NO. 1

FARM Robbins ILOC. C NE

GEOL. _____

CONTR. _____

POOL Glick

SPUD _____

Location

CO.

LSE.

NO.

SEC.

TWP.

RGE.

25

ABANDONED

CO. Kiona ELEV. 1983SEC. 25 TWP. 30 RGE. 17WCOMPANY Gulf Oil Corp NO. 1

JAN 22 '58

FARM Robbins ILOC. C NE

GEOL. _____

CONTR. _____

POOL GlickSPUD 11-28-37Location NOV 17 '37

MIRT DEC 4 '37

8" 402/325

Ø 2427 DEC 11 '37

Ø 3802 DEC 18 '37

BL 4211 LKK

TD 5070

+231 Ø 4555 DEC 26 '37

Mchert 4832 DST 4827 - 76 60'

gls ga 363 mcf

re 75 M FP 65-75

BHP 1655 - 1450/30"

ran log Hb 404/ Dg 4072

BL 4211 LKK 4230 Mar m

46.64 mchert 4832 K

5058 DST (DP) 4875 -

4905 60" 8 1/4"

573 mcf run 60' gum

50 kcs oil 250' g 60' 60' is

cm 2090 oil TD 5070

4 1/2" 4982/150 woc

JAN 2 '58

96/4833-56 250A

frac JAN 8 '58 JAN 15 '58 20/4880-85

PKr 4870 \$10 B.F 290.01'

9 hrs ga 125 mcf

Ø 9BF 290 oil 5 hrs

250A F10680 51BW 24 hrs

24/64" chk ga 989 mcf

K 59 DOCK 59

JAN 22 '58

F10 279 mcf + 428W

1 Bld 20/64" ch 24 hrs

D6A