

Section 25 Township 30 Range 12 W

Well No. # 1 H. E. Schmidt

Company Purcell & Mull

NORTH

					0		

WEST

EAST

SOUTH

SEC.	TWP.	R.
25	30	12W

WELL NO. #1 H.E. Schmidt FARM

COMPANY Purcell & Mull

CONTRACTOR Co. Tools.
Wildcat.


330 Ft. from N. Line

Ft. from S. Line

Ft. from E. Line

990 Ft. from W. Line

NE NW NE

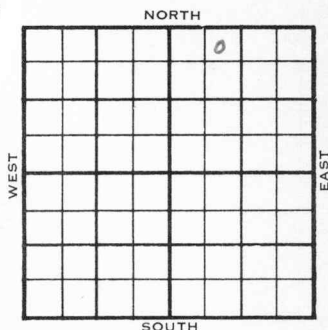

1955	ELEVATION 1791'	REPORT
------	--------------------	--------

3/16 Spud 3-12-55

8" @ 411'

Drlg. 1975'

4/20 Spud 3-12-55 D & A TD 4460'

8" @ 411 Elgin 3573'

DST 3574-80 open 1 hr rec 20' mud 240#

Heeb 3695 Doug 3743

DST 3729-49 open 45 min rec 20' mud Off

Br. lime 3885

DST 4382-95 open 2 hr gas in 1 hr

50 min, rec 30' mud. Off

Miss 4397'

DST 4399-4417 open 1 hr 20 min, rec 80' mud Off

DST 4380-4400 open 2 hr gas in 1½ hr, rec 25' SGCM, 806# TD 4460

5" @ 4460 CO 60/4397-4407

frac. S/33 BF 90% wtr. SP 4391

40/4380-88 wtr. D & A

ABANDONED

