

KANSAS


FORM 51 5M 6-46 PETROL

Grant County

Section 25 Township 30 Range 36-W

Well No. #1 Blanche Evans

Company United Prod.

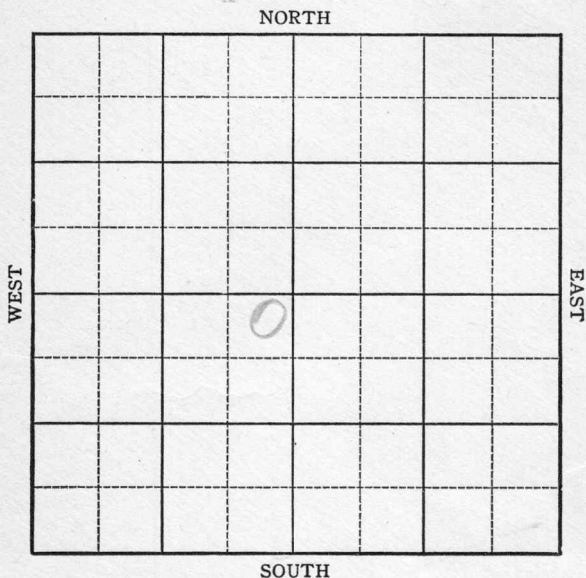

Sec. 25 Twp. 30 R. 36W

Well No. #1 Blanche Evans Farm _____

United Prod.

Company _____

Hugoton


100 Ft. from N. Line

_____ Ft. from S. Line

200 Ft. from E. Line

_____ Ft. from W. Line

NE SW

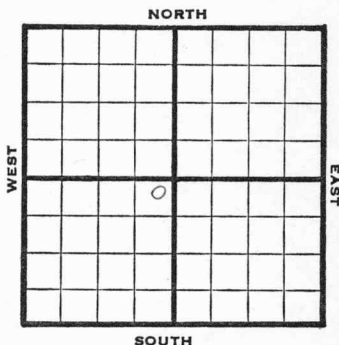

1946

2900

REPORT

7/10 Loca ion

7/16 "

7/23 RUR

7/30 "

8/6 TD 2420

7" @ 2410

RUST

8/13 Drlg 2519'

8/20 TD 2617

227' of 5" Perf liner @ 2617

12000 acid

8/27 " " "

9/5 " " "

9/10 " " "

9/18 " " "

9/24 " " "

10/2 7" @ 2410

227' of 5" Perf liner @ 2617'

TD 2617'

12,000 Acid

13,650,000 Gas

413# Rpr

COMPLETED

KANSAS
 Map No. 1 Sec. 25 Twp. 30 R. 36 W
 Well No. 1 Blanche Evans

United Prod. Company

FIRST REPORT Contractor

NE SW

SECTION PLAT

100 Ft. from N. Line

 Ft. from S. Line

200 Ft. from E. Line

 Ft. from W. Line

	o		

Grant County

Location X

Rig up

Drilling and Remarks:

RECORD

Cased in., ft.

Sand

Gas

Oil

Total Depth

PRODUCTION

1st 24 hrs. Nat.

1st 24 hrs. after shot

Gas Cu. Ft.

Dry Hole

Abandoned

Date

JUL 10 1946

19

S. J. LEWIS

Scout

KANSAS Kansas Pool Name Hugoton PoolMap No. _____ Sec. 25 Twp. 30 R. 36WWell No. 1 Blanche Evans

_____ United Prod. _____ Company

COMPLETED

_____ Contractor

NE SW

E12900
SECTION PLAT

	o		

100 Ft. from N. Line

_____ Ft. from S. Line

200 Ft. from E. Line

_____ Ft. from W. Line

Grant County

Location _____

Rig up _____

Drilling and Remarks:

7" @ 2418
 227' 2" 5" Prof lined
 @ 2617
 12000 acril
 13,650,000 Gas
 422 # R/B

RECORD

Cased _____ in., _____ ft.

Sand _____

Gas _____

Oil _____

Total Depth 2617**PRODUCTION**

1st 24 hrs. Nat. _____

1st 24 hrs. after shot _____

Gas _____ Cu. Ft.

Dry Hole _____

Abandoned _____

Date

OCT 2 1946 19 _____

S. J. LEWIS Scout