

KANSAS

Haskell

Section 25 Township 30 Range 34W


Well No. 1 Schelenber

Company Cities Service

Hugton

NORTH

WEST

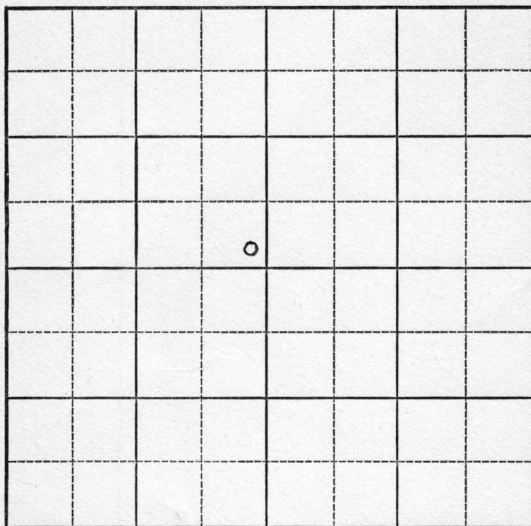

EAST

SOUTH

KANSAS Haskell

Sec. 25 Twp. 30 R. 34W ✓

Well No. #1 Schelenber Farm

Cities Service Company


Hugoton Pool

 Ft. from N. Line

100' Ft. from S. Line

100' Ft. from E. Line

 Ft. from W. Line

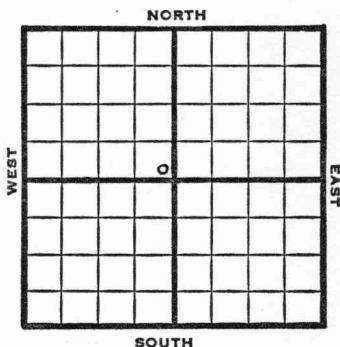

SE NW

1949

Elev 2956'

REPORT

6/1	Location
6/7	"
6/15	"
6/21	"
6/28	8" @ 640'
7/6	5" @ 2769'
	TD 2770'
7/12	"
7/20	470 shots 2602-2746'
	25500 acid
7/27	"
8/3	TD 2770'
	5" @ 2769'
	Perf 34500 acid
	14 M Gas
	408# R Pr
	Comp

COMPLETED

Map No. _____ Sec. 25 Twp. 30 R. 34W

Well No. 1 Schelenber

Cities Service Company

Contractor

SE NW


FIRST REPORT
SECTION PLAT

_____ Ft. from N. Line

100 Ft. from S. Line

100 Ft. from E. Line

_____ Ft. from W. Line

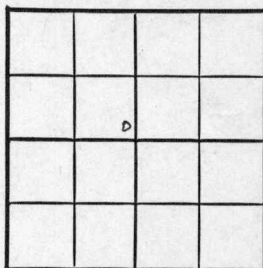

Haskell County

Location X

Rig up _____

Drilling and Remarks:

RECORD

Cased _____ in., _____ ft.

Sand _____

Gas _____

Oil _____

Total Depth _____

PRODUCTION

1st 24 hrs. Nat. _____

1st 24 hrs. after shot _____

Gas _____ Cu. Ft.

Dry Hole _____

Abandoned _____

Date

JUN 1 1949 19

S. J. LEWIS Scout

Kansas

Hugoton Pool

Map No. ✓ Sec. 25 Twp. 30 R. 34WWell No. 1 Schelenberg

Cities Service


Company

COMPLETE

Contractor

SE NW

E 12956

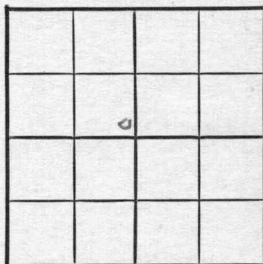SECTION PLAT Ft. from N. Line100 Ft. from S. Line100 Ft. from E. Line Ft. from W. Line

Haskell County

Location Rig up

Drilling and Remarks:

*5" @ 2768**Perf.**34500 sand**14 M. Gas**408° R/R***RECORD**Cased in., ft.Sand Gas Oil Total Depth 2270**PRODUCTION**1st 24 hrs. Nat. 1st 24 hrs. after shot Gas Cu. Ft.Dry Hole Abandoned

Date

AUG 3

1949

19

S. J. LEWIS

Scout