DX 78-1

Kingman

KANSAS

Section 25 Township 30 Range 8 W

Well No. #1 Kiger

Company Purcell & Mull

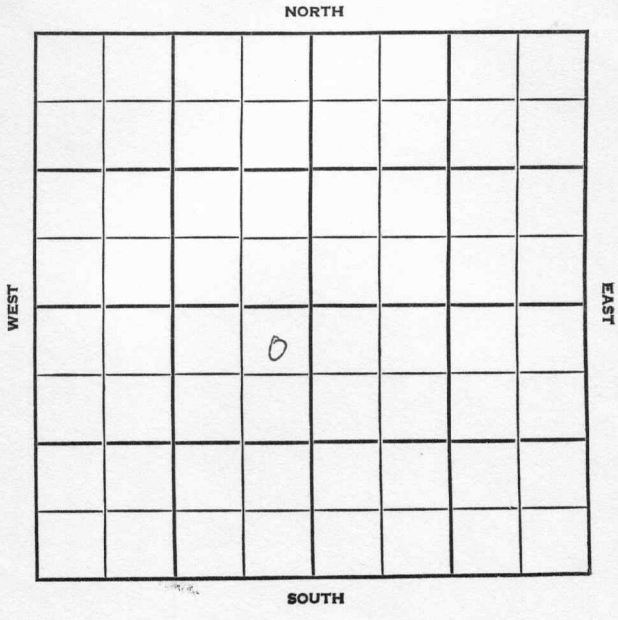

Kingman KANSAS

SEC.	TWP.	R.
25	30	8 W

WELL NO.

1 Kiger FARM

COMPANY

Purcell & Mull

CONTRACTOR

Co. tools

Spivey

_____ Ft. from N. Line

_____ Ft. from S. Line

_____ Ft. from E. Line

_____ Ft. from W. Line

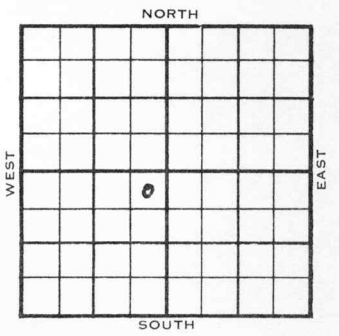

NE NE SW
SDX - 1 Mile
Magnolia FO

1955	ELEVATION 1612' REPORT
8/3	MIR
8/11	Spud 8-2-55, 8 5/8" @154/125, Drlg. 3600
8/18	DST 4329-40 open 2 hr. Rec. 630' GIP 120' g & soc Drlg mud, 80/20", DST 4340-53, open 2 hr. Rec. 2700' GIP, 55' oily mud, 50' socm, 435/20", 5½" 4357/100
8/31	Comm 8/2/55 M 4326 TD 4357 8 5/8 @ 154 w/125 DST 4329-40 open 2 hrs 630 GIP Rec 120' G&SOC drlg mud FP 28-40 BHP 80# 20" DST 4340-53 open 2 hrs 2700' GIP Rec 55' oily mud plus 50' socm BHP 435 20" 5 1/2" 4357 w/100 60/4328-38 500 acid SWB 6 bo in 8 hrs Frac SWB 3½ bo plus ~~5~~ 40½ bwph 4 hrs D & A ABANDONED

+ 4326
1612
2714

DX-78

FORM 513 REV. SUNRAY

County Kingman Elev.

Sec. 25 Twp. 30 Rge. 8W

Company Purcell & Mull

Farm Name Kiger No. 1

TOPS	DEPTH	LOG	DATUM
Anh.			
T.p.			
H.			
Tr.			
Dg.			
B.L.			
L.			
K.C.			
B.K.C.			
Ce.			
C.			
M.			
M.			
K.			
Mz.			
Mq.			
V.			
S.			
S.			
A			
R.			
P€.			
G.			
T.D.			

Loc. in Sec. NE NE SW

Geol.

Contr. Co. tools

Pool Spivey

AUG 3 '55

1 mile

FIRST REPORT

Date Comm.

Magnolia FO

M I R

Co. Lse. No. Sec. T. R.

FORM 513 REV. SUNRAY

County Kingman Elev. 1612

Sec. 25 Twp. 30 Rge. 8W

Company Purcell & Mull

Farm Name Kiger No. 1

TOPS	DEPTH	LOG	DATUM
Anh.			
Tp.			
H.			
Tr.			
Dg.			
B.L.			
L.			
K.C.			
B.K.C.			
Ce.			
C.			
M.	4326		2714
M.			
K.			
Mz.			
Mo.			
V.			
S.			
S.			
A			
R.			
P€.			
G.			
T.D.	4357		

Loc. in Sec. NE NE SW

Geol.

Contr. Co. tools

Pool Spivey



AUG 3 1 1955

Date Comm. 8/2/55 Magnolia FO

8 5/8 154 w/125 DST 4329-40 open 2 hrs

630! GIP Rec. 120' g&soc drlg mud FP

28-40 BHP 80# 20" DST 4340-53 open 2 hrs

2700' GIP Rec. 55' oily mud plus 50' socm

BHP 435 20" 5½" 4357 w/100 60/4328-38

500 acid SWB 6 bo in 8 hrs Frac

SWB 3½ bo plus 40½ bwph 4 hrs

D & A

Co. Lse. No. Sec. T. R.