


Section 25 Township 30 Range 8 W

Well No. # 4 Stevens

Company Champlin Refg.

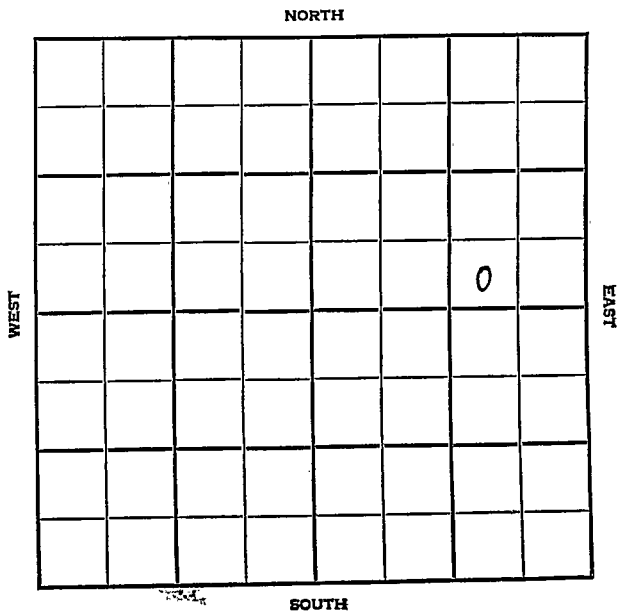

| | | |
|------|------|----|
| SEC. | TWP. | R. |
| 25 | 30 | 8W |

WELL NO.

#4 Stevens

FARM

COMPANY

Champlin Refining.

CONTRACTOR

Big Chief.

E. Spivey Pool NORTH

_____ Ft. from N. Line

330


_____ Ft. from S. Line

990

_____ Ft. from E. Line

_____ Ft. from W. Line

SW SE NE

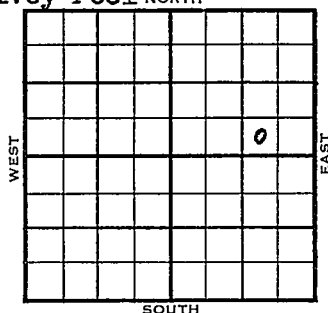

| | | |
|------|-----------|--------|
| | ELEVATION | REPORT |
| 1954 | 1559' | |

12/29

Location

1955
2/16

Spud 12-30-54 Oil well TD 4363
 8" @ 314 Lans 3449 Miss. 4254'
 DST 4290-4318, open 1 hr red 270'
 SO & GCM, 259' HO & GCM, 75' SW
 1005# TD 4363' 5" @ 4362 CO
 PB 4324' 56/4258-72 frac. 250 M-A
 F/140 BO 10 BW 20 hr.
 Comp. F/276 BOPD 2% wtr.

COMPLETED

County Kingman State Kansas

Sec. 25 (Blk. 30) (Sur. 8W) (Twp.) (Rge.) Map No.

Operator Champlin Ref.

Well No. 4 Farm Stevens

Elev. 1559 Location SW SE NE

| | | | | | |
|--|--|--|--|--|--|
| | | | | | |
| | | | | | |
330 Ft. From S Line NE

990 Ft. From E Line Quarter

Ist. Report

Completion FEB 16 1955

Remarks E. Spivey Pool

Big Chief - Contr.

Spudding Date. 12-30-54

Drilg. Data Oilwell TD 4363

8" @ 314 Lens. 3449 Miss. 4254

DST 4290-4318 open 1 hr. Rec. 270' so &

gcm. 259' ho & gcm 75' sw 1005#

TD 4363 5" @ 4362 Co PR 4324

56/ 4258-72 frac 250 M-A F/ 140 bo.

10 bw 20 hr. Comp. F/ 276 bopd 2% wtr.

FABEN GILSTRAP