


Section 25 Township 30 Range 2 W

Well No. # 1 Grellner

Company E. F. Wakefield

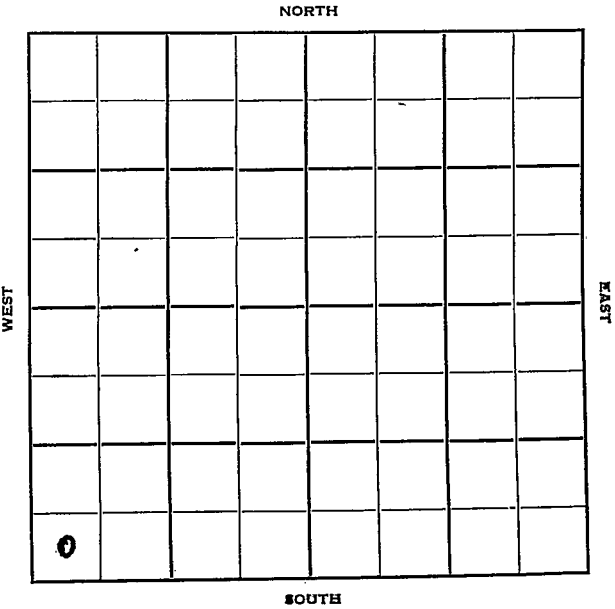

Summer

KANSAS

Sec. 25 Twp. 30 R. 2W

Well No. #1 Grellner Farm

E. F. Wakefield Company

Wakefield Contractor

Anson Pool

Ft. from N. Line


330 Ft. from S. Line

Ft. from E. Line

330 Ft. from W. Line

SW SW SW

Atl.-Cree farmout

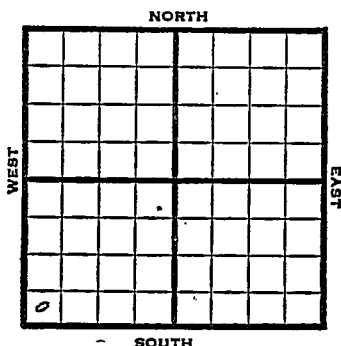

1952

Elev. 1339' REPORT

10/1 Location

10/8 RU

10/15 8" @ 112'

10/22 Drlg. 1510'

10/29 Br li 2762', Stal 2773, KC 3094
DST 3274-84 1 hr., 1000' gas, 90'
O&GCM 305#
Drlg. 3312'

11/5 Marm 3324, Cherokee 3583,
Miss 3755
DST 3779-95, 75 mins., 120' GCM
60' O&GCM 600#
TD 3795
5" @ 3779

11/12 NO

11/20 CO to 3795' S/4 B0 plus 4 BWPD

11/27 NR

12/4 500A 10 BOPD PB
30/3274-84

12/11 NR

12/18 Sq Perfs

12/25 " "

OVER

1953

1/1 NR

1/8 NR

1/23 Spud 10-10-52 Oil well TD 3795'
8" @ 112 Br lime 2762' Stal 2773'
KC 3094'
DST 3274-84 open 1 hr. rec 1000' gas
90' O & GCM 305#
Marm. 3324' Cherokee 3583' Miss 3755'
DST 3779-95 open 75 min rec 120' GCM
60' O & GCM 600# TD 3795'
5" @ 3779 CO to 3795 S/4 B0 4BWPD
500 mud acid 10 BOPD PB
30/3274-84 2000 A S/4 B0 16 BW
18 hr.
Comp. 25 BOPD 25 BW

COMPLETED

County Sumner State Kansas
 Sec. 25 (Blk.) 30 (Sur.) 2W Map No.
 Operator E. F. Wakefield
 Well No. 1 Farm Grellner
 Elev. _____ Location SW SW SW

FIRST REPORT


330 Ft. From S Line SW
330 Ft. From W Line Quarter
 1st. Report OCT 1 1952
 Completion _____
 Remarks Atl.-Cree farmout
Wakefield - Contr.
 Spudding Date _____

Drlg. Data

Anson PoolLocation

Scout Cards
Land Small Map
Land Wall Map
Tearings
France Map
Pierce Map
OCT 3 1952

County Sumner State Kansas
 Sec. 25 (Blk. 30 (Sur. 2W Map No.
 (Twp.) (Rge.)
 Operator E. F. Wakefield
 Well No. 1 Farm Grellner
 Elev. 1339 Location SW SW SW

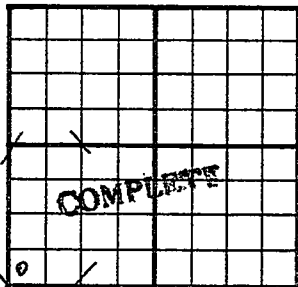

330 Ft. From S Line SW

330 Ft. From W Line Quarter

1st. Report

Completion JAN 23 1953

Remarks Anson Pool

Wakefield - Contr.

Spudding Date 10-10-52

Drig. Data Oil well TD 3795

8" @ 112 Br. lime 2762 Stal. 2773

KC 3094 DST 3274-84 open 1 hr.

Rec. 1000' gas 90' o & gcm 305#

Marm. 3324 Cherokee 3583 Miss. 3755

DST 3779-95 open 75 min. Rec. 120' gcm

60' o & gcm 600# TD 3795 5" @ 3779

CO to 3795 S/ 4 bo 4 bwpd 500 mud acid

10 hpd PB 30/ 3274-84 2000 A

S/ 44 bo 16bw 18 hr.

Comp. 25 bopd 25 bw

J. G. McGEHEE

JAN 29 1953

Scout Cards *mm*

Land Small Map

Land Wall Map

Tracings

France Map

Pieces Map

Misc.

Orig. Data